

Hancock
K 2415

MISSISSIPPI
BOARD OF WATER COMMISSIONERS
416 North State Street
Jackson, Mississippi 39201

WATER WELL DRILLERS LOG

July 12 1982 Ward Well Dr. Hancock
date well completed firm name county well located

LANDOWNER: Fony Romana
Hancock - West Jones
Bay St. Louis
(mailing address)

description of formations encountered	from	to
<u>Top Soil - clay</u>	<u>0</u>	<u>15</u>
<u>sd</u>	<u>15</u>	<u>42</u>
<u>clay</u>	<u>42</u>	<u>105</u>
<u>sd</u>	<u>105</u>	<u>127</u>
<u>clay</u>	<u>127</u>	<u>146</u>
<u>sd - Red gravel</u>	<u>146</u>	<u>165</u>

WELL LOCATION:
sec 6 T 9 N R 14 E
12 1/2 miles SW of B. S. L.
(distance) (direction) (nearest town)

WELL PURPOSE: Home
(home, irrigation, municipal, industrial)

- WELL COMPLETION DATA:
- (1) diameter (inches) 2"
 - (2) total depth (feet) 165
 - (3) static water level (feet) 10 ^{below} above top of ground.
 - (4) casing PVC, 155
(material) (depth)
 if telescope see back.
(size)
 - (5) screen 10' -
(length) (depth to top)
2" PVC
(size) (material)
 - (6) pump 1/2 10
(HP) (yield gpm)
elec.
(type power)
 - (7) electric log NO
(yes or no)
N/A
(organization/running log)
 - (8) how well bottom plugged BWV


DRILLERS REMARKS: N/A

DEPT. OF NATURAL RESOURCES
BUREAU OF LAND & WATER RESOURCES

RECEIVED
AUG 16 1982

If well telescopes please sketch and show depths.

GROUND LEVEL

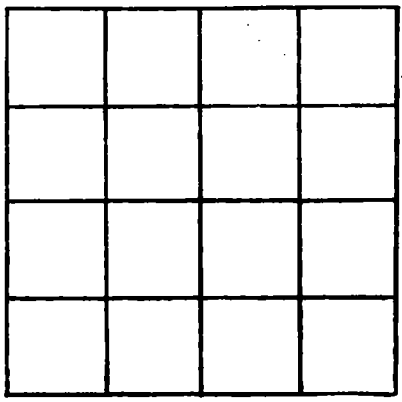

SECTION 6

Please indicate well location X.

ADDITIONAL INFORMATION

A series of horizontal lines for recording additional information, starting below the 'ADDITIONAL INFORMATION' header and extending to the bottom of the page.

If more than one screen, show locations of each on sketch.