

Hanceck
K 2479

MISSISSIPPI DEPARTMENT OF NATURAL RESOURCES
Bureau of Land and Water Resources
Southport Mall
P.O. Box 10631
Jackson, Mississippi 39209
WATER WELL DRILLERS LOG

7-19⁸² 19 date well completed POLINCEY WATER WELL DRILLING firm name Hanceck county well located

LANDOWNER: H. J. Mouton
Shoreline Park -
Cardinal St.
(mailing address)

WELL LOCATION:
sec. 39 T 8 N R 14 E
3 miles (distance) W (direction) of Bay St Louis (nearest town)

WELL PURPOSE: Comp
(home, irrigation, municipal, industrial)

WELL COMPLETION DATA:
(1) diameter (inches) 2
(2) total depth (feet) 185
(3) static water level (feet) 5 below above top of ground.
(4) casing Pvc 180
(material) (depth)
2 (size) If telescope see back.
(5) screen 5 180
(length) (depth to top)
2 Pvc (size) (material)
(6) pump Owner
(HP) (yield gpm)
(type power)
(7) electric log /
(yes or no)
(organization running log)
(8) how well bottom plugged Sealed

description of formations encountered	from	to
	<u>Fill</u>	<u>0</u>
<u>Junk sd - swamp</u>	<u>10</u>	<u>90</u>
<u>Blue Clay</u>	<u>90</u>	<u>112</u>
<u>Bay St Louis sd</u>	<u>112</u>	<u>185</u>


DEPT. OF NATURAL RESOURCES
BUREAU OF LAND & WATER RESOURCES
AUG - 6 1982

RECEIVED

DRILLERS REMARKS:

If well telescopes please sketch and show depths.

GROUND LEVEL

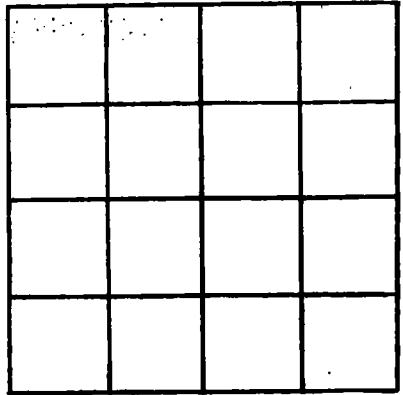

SECTION _____

Please indicate well location X.

ADDITIONAL INFORMATION

If more than one screen, show locations of each on sketch.