

MISSISSIPPI DEPARTMENT OF NATURAL RESOURCES

Bureau of Land and Water Resources

Southport Mall

P.O. Box 10631

Jackson, Mississippi 39209

WATER WELL DRILLERS LOG

Hancock
K 2490

82

19 POUNCEY WATER WELL DRILLING

Hancock

date well completed

firm name

county well located

LANDOWNER:

John Tessitore

description of formations encountered

from

to

Shore Line -

Shore - e whalc
(mailing address)

Will & Swamps 0 12

Jank - sd silt shale 12 40

WELL LOCATION:

sec. 39 T 8 N R. 14 E
3 miles (distance) W (direction) of Bay St. Louis (nearest town)

Clay & Shell Jank 40 128

sd. silt. fine 128 176

WELL PURPOSE:

(home, irrigation, municipal, industrial)

Comp.

sd. fine some silt 176 190

WELL COMPLETION DATA:

- (1) diameter (inches) 2
- (2) total depth (feet) 190
- (3) static water level (feet) 3 (below top of ground) above
- (4) casing PVC (material) 155 (depth)
- 2 (size) if telescope see back.
- (5) screen 5 (length) 185 (depth to top)
- 2 (size) PVC (material)
- (6) pump 1/2 (HP) 10 (yield gpm)
- AC 220 (type power)
- (7) electric log / (yes or no)
- / (organization running log)
- (8) how well bottom plugged Sealed

DEPT. OF NATURAL RESOURCES
BUREAU OF LAND & WATER RESOURCES


AUG - 6 1982

RECEIVED

DRILLERS REMARKS:

If well telescopes please sketch and show depths.

GROUND LEVEL

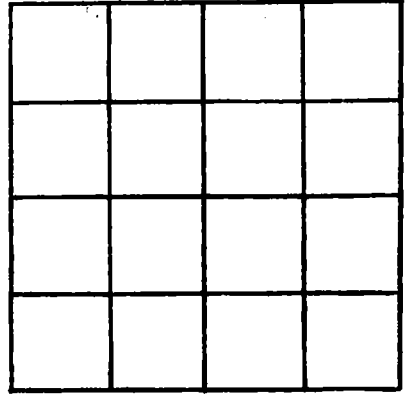

SECTION _____

Please indicate well location X.

ADDITIONAL INFORMATION

If more than one screen, show locations of each on sketch.