

HANCOCK
 K 2821
 7-23-82

MISSISSIPPI
 BOARD OF WATER COMMISSIONERS
 416 North State Street
 Jackson, Mississippi 39201

WATER WELL DRILLERS LOG

July 23 1982 used well log Hancock
 date well completed firm name county well located

LANDOWNER	description of formations encountered	from	to
Queen Leaf Nursery	Top Soil - clay	0	16
Washington Rd.	SD	16	42
Bay St. Louis ms.	clay - silt	42	345
(mailing address)	med. coarse SD	345	376

WELL LOCATION:

7 sec. 39 T 8 N R 13 E 14
 1/8 miles N of B.S.L.
 (distance) (direction) (nearest town)

WELL PURPOSE: irrigation
 (home, irrigation, municipal, industrial)

WELL COMPLETION DATA:

- (1) diameter (inches) 4" X 2"
- (2) total depth (feet) 376
- (3) static water level (feet) 1 below top of ground.
- (4) casing PVC 356
 (material) (depth)
 4 X 2 (size) if telescope see back.
- (5) screen 20' -
 (length) (depth to top)
 2" PVC
 (size) (material)
- (6) pump 2 45
 (HP) (yield gpm)
 Elec.
 (type power)
- (7) electric log NO
 (yes or no)
 N/A
 (organization running log)
- (8) how well bottom plugged BWV

DEPT. OF NATURAL RESOURCES
 BUREAU OF LAND & WATER RESOURCES

SEP 10 1982


RECEIVED

DRILLERS REMARKS: N/A

If well telescopes please sketch and show depths.

111
5-38-5

GROUND LEVEL

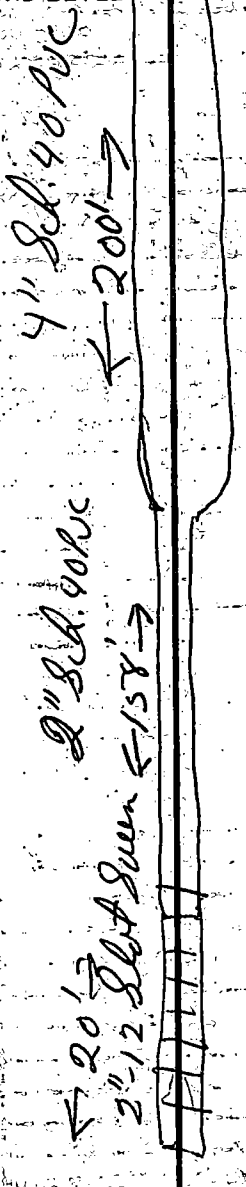

SECTION 39

Please indicate well location X.

ADDITIONAL INFORMATION

If more than one screen, show locations of each on sketch.