

Hancock

MISSISSIPPI DEPARTMENT OF NATURAL RESOURCES

Bureau of Land and Water Resources

Southport Mall

P.O. Box 10631

Jackson, Mississippi 39209

WATER WELL DRILLERS LOG

R 2426
8-10-82

8-10-1982 date well completed
Hancock firm name
Hancock county well located

LANDOWNER: Winston Auel
Central & First
Bay St. Louis, ms.
(mailing address)

description of formations encountered

from to

<u>Clay - Silt</u>	<u>0</u>	<u>14</u>
<u>sd</u>	<u>14</u>	<u>38</u>
<u>Clay</u>	<u>38</u>	<u>95</u>
<u>fine sd</u>	<u>95</u>	<u>110</u>
<u>Clay - Silt</u>	<u>110</u>	<u>156</u>
<u>Coarse sd</u>	<u>156</u>	<u>170</u>

WELL LOCATION: 4
sec. 28 T. 8 N. R. 13 E.
9 miles N of Wardland
(distance) (direction) (nearest town)

WELL PURPOSE: None
(home, irrigation, municipal, industrial)

- WELL COMPLETION DATA:
- (1) diameter (inches) 2"
 - (2) total depth (feet) 170
 - (3) static water level (feet) 5 ^{below} _{above} top of ground.
 - (4) casing PVC, 160,
(material) (depth),
- if telescope see back.
(size)
 - (5) screen 18', -
(length) (depth to top)
2", PVC
(size) (material)
 - (6) pump 1/2, 12
(HP) (yield gpm)
Elec.
(type power)
 - (7) electric log No
(yes or no)
N/A
(organization running log)
 - (8) how well bottom plugged BWU

DRILLERS REMARKS: N/A


DEPT. OF NATURAL RESOURCES
BUREAU OF LAND & WATER RESOURCES

SEP - 9 1982

RECEIVED

If well telescopes please sketch and show depths.

GROUND LEVEL

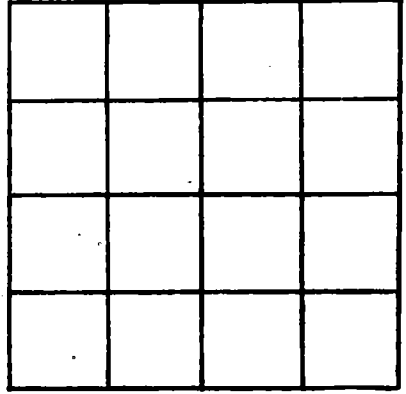

SECTION 28

Please indicate well location X.

ADDITIONAL INFORMATION

If more than one screen, show locations of each on sketch.