

MISSISSIPPI DEPARTMENT OF NATURAL RESOURCES

Bureau of Land and Water Resources

Southport Mall

P.O. Box 10631

Jackson, Mississippi 39209

WATER WELL DRILLERS LOG

Hancock
K22425

8-16- 1982 Ward Well Dr. Hancock
date well completed firm name county well located

LANDOWNER	description of formations encountered	from	to
<u>Charles Ashley</u>	<u>Fill - clay</u>	<u>0</u>	<u>16</u>
<u>Ave. C & 10th</u>	<u>Clay - Silt</u>	<u>16</u>	<u>35</u>
<u>Boy St. Sorin ms.</u>	<u>sd</u>	<u>35</u>	<u>82</u>
(mailing address)	<u>sd</u>	<u>82</u>	<u>96</u>
WELL LOCATION:	<u>clay</u>	<u>96</u>	<u>102</u>
sec. <u>28</u> T <u>8</u> N R. <u>13</u> E <u>14</u> W	<u>fine sd</u>	<u>102</u>	<u>116</u>
<u>8</u> miles <u>N</u> of <u>Warland</u>	<u>Clay - Silt</u>	<u>116</u>	<u>155</u>
(distance) (direction) (nearest town)	<u>med. coarse sd</u>	<u>155</u>	<u>170</u>

WELL PURPOSE: Home
(home, irrigation, municipal, industrial)

WELL COMPLETION DATA:

- (1) diameter (inches) 2"
- (2) total depth (feet) 170
- (3) static water level (feet) 6 ^{below} above top of ground.
- (4) casing PVC, 160,
(material) (depth)
- if telescope see back.
(size)
- (5) screen 10', -
(length) (depth to top)
2", PVC
(size) (material)
- (6) pump owner -
(HP) (yield gpm)
-
(type power)
- (7) electric log no
(yes or no)
N/A
(organization running log)
- (8) how well bottom plugged BWU

DRILLERS REMARKS: N/A


DEPT. OF NATURAL RESOURCES
BUREAU OF LAND & WATER RESOURCES

SEP 23 1982

RECEIVED

If well telescopes please sketch and show depths.

GROUND LEVEL

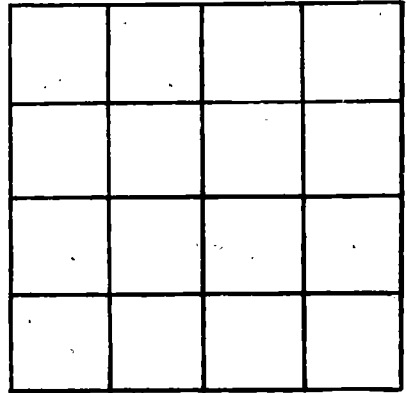

SECTION 28

Please indicate well location X.

ADDITIONAL INFORMATION

If more than one screen, show locations of each on sketch.