

MISSISSIPPI DEPARTMENT OF NATURAL RESOURCES

Bureau of Land and Water Resources

Southport Mall

P.O. Box 10631

Jackson, Mississippi 39209

WATER WELL DRILLERS LOG

Hancock
R2428

8-17-

19

82 Wardwell Dr.

Hancock

date well completed

firm name

county well located

LANDOWNER: W.D. Olson
Ohio & Ark. St.
Bay St. Louis, ms.
(mailing address)

description of formations encountered	from	to
<u>Clay</u>	<u>0</u>	<u>18</u>
<u>sd</u>	<u>18</u>	<u>42</u>
<u>Clay - Silt</u>	<u>42</u>	<u>95</u>
<u>Fine - sd</u>	<u>95</u>	<u>118</u>
<u>Clay - Silt</u>	<u>118</u>	<u>162</u>
<u>Fine sd</u>	<u>162</u>	<u>176</u>
<u>Clay - Silt</u>	<u>176</u>	<u>352</u>
<u>sd</u>	<u>352</u>	<u>372</u>

WELL LOCATION:
sec. 40 T. 8 N. R. 13 E. 14
15 miles N of Wardwell
(distance) (direction) (nearest town)

WELL PURPOSE: Home
(home, irrigation, municipal, industrial)

WELL COMPLETION DATA:

(1) diameter (inches) 2"

(2) total depth (feet) 372

(3) static water level (feet) 1' below above top of ground.

(4) casing PVC, 362,
(material) (depth)
— If telescope see back.
(size)

(5) screen 10', —
(length) (depth to top)
2", PVC
(size) (material)

(6) pump owner
(HP) (yield gpm)
—
(type power)

(7) electric log NO
(yes or no)
N/A
(organization running log)

(8) how well bottom plugged B.W.V.

DEPT. OF NATURAL RESOURCES
BUREAU OF LAND & WATER RESOURCES


SEP 23 1987

RECEIVED

DRILLERS REMARKS:

If well telescopes please sketch and show depths.

GROUND LEVEL

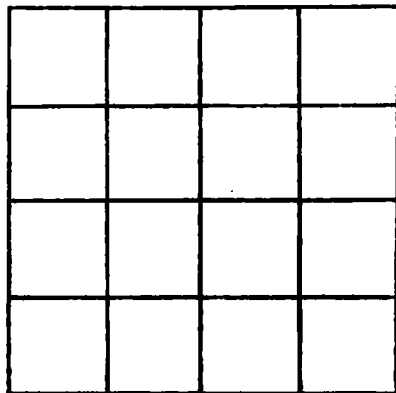

SECTION 40

Please indicate well location X.

ADDITIONAL INFORMATION

If more than one screen, show locations of each on sketch.