

Hancock  
R 2432

MISSISSIPPI DEPARTMENT OF NATURAL RESOURCES  
 Bureau of Land and Water Resources  
 Southport Mall  
 P.O. Box 10631  
 Jackson, Mississippi 39209  
**WATER WELL DRILLERS LOG**

Jan 15-83 Cochran water well service Hancock  
 date well completed firm name county well located

LANDOWNER:  
Bob Blanco  
Rt 2 (Poplarville)  
 (mailing address)

description of formations encountered	from	to
Top Soil	0	1
Gray clay	1	5
Brown clay	5	16
sand	16	71
Blue clay	71	150
Sand	150	170

WELL LOCATION:  
 sec 28 T 8 N R 14 E  
2 miles N.W. of Waveland  
 (distance) (direction) (nearest town)

WELL PURPOSE: Home  
 (home, irrigation, municipal, industrial)

WELL COMPLETION DATA:

(1) diameter (inches) 2"

(2) total depth (feet) 170'

(3) static water level (feet) 6 <sup>below</sup> above top of ground.

(4) casing Pvc, 160'  
 (material) (depth)  
2"  
 (size) If telescope see back.

(5) screen 10', 160'  
 (length) (depth to top)  
2", PVC  
 (size) (material)

(6) pump \_\_\_\_\_ (HP) \_\_\_\_\_ (yield gpm)  
 (type power) \_\_\_\_\_

(7) electric log \_\_\_\_\_ (yes or no)  
 (organization running log) \_\_\_\_\_

(8) how well bottom plugged quite

DRILLERS REMARKS:


DEPT. OF NATURAL RESOURCES  
 BUREAU OF LAND & WATER RESOURCES

APR 27 1983

RECEIVED

If well telescopes please sketch and show depths.

GROUND LEVEL

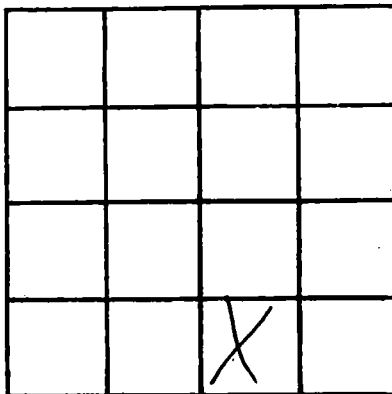

SECTION 28

Please indicate well location X.

ADDITIONAL INFORMATION

If more than one screen, show locations of each on sketch.