

MISSISSIPPI DEPARTMENT OF NATURAL RESOURCES

Bureau of Land and Water Resources

Southport Mall

P.O. Box 10631

Jackson, Mississippi 39209

WATER WELL DRILLERS LOG

Hancock  
K2436

2-9 1983 Duncan Well Drilling Hancock  
date well completed firm name county well located

LANDOWNER: Donald Leonard  
822 Hwy. 90  
Bay St. Louis Ms.  
(mailing address)

description of formations encountered	from	to
clay	0	10
sand	10	50
blue clay	50	95
clay & sand	95	135
coarse sand	135	155

WELL LOCATION:  
sec. 18 T 12 N R 14 E  
5 miles SW of Etcheland  
(distance) (direction) (nearest town)

WELL PURPOSE: Home  
(home, irrigation, municipal, industrial)

WELL COMPLETION DATA:

- (1) diameter (inches) 4"
- (2) total depth (feet) 155'
- (3) static water level (feet) \_\_\_\_\_ below/above top of ground.
- (4) casing pvc (material), 145' (depth)  
\_\_\_\_\_ (size) If telescope see back.
- (5) screen 10' (length), 145' (depth to top)  
2" (size), pvc (material)
- (6) pump \_\_\_\_\_ (HP) \_\_\_\_\_ (yield gpm)  
\_\_\_\_\_ (type power)
- (7) electric log \_\_\_\_\_ (yes or no)  
\_\_\_\_\_ (organization running log)
- (8) how well bottom plugged hard  
shack

DRILLERS REMARKS: Owner installed his own pump


DEPT. OF NATURAL RESOURCES  
BUREAU OF LAND & WATER RESOURCES

AUG 12 1983

RECEIVED

If well telescopes please sketch and show depths.

GROUND LEVEL

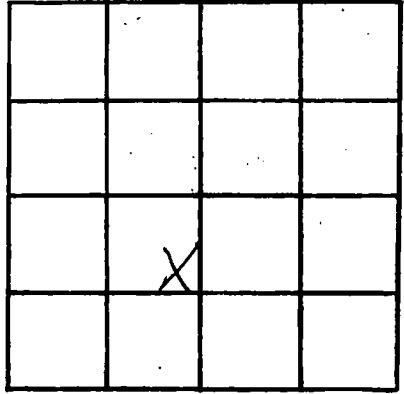

SECTION 18

Please indicate well location X.

ADDITIONAL INFORMATION

Lined area for additional information.

If more than one screen, show locations of each on sketch.