

MISSISSIPPI DEPARTMENT OF NATURAL RESOURCES

Bureau of Land and Water Resources

Southport Mall

P.O. Box 10631

Jackson, Mississippi 39209

WATER WELL DRILLERS LOG

Hancock
K2437

2-21-

1983 McNeil Well Works Inc. Hancock

date well completed

firm name

county well located

LANDOWNER: Joe Vincent
Gen. Del.
Pearlington Mo. 39572
(mailing address)

description of formations encountered

from

to

MUD
SAND
SAND

0 80
80 100
100 120

WELL LOCATION:

sec 29 T 10 N R 14 E
3 miles NE of Polkton
(distance) (direction) (nearest town)

WELL PURPOSE: home
(home, irrigation, municipal, industrial)

WELL COMPLETION DATA:

- (1) diameter (inches) 2"
- (2) total depth (feet) 120'
- (3) static water level (feet) 25' below above top of ground.
- (4) casing Sch. 40 PVC 110'
(material) (depth)
2" If telescope see back.
(size)
- (5) screen 10' 110'
(length) (depth to top)
2" Sch. 80 PVC
(size) (material)
- (6) pump 1 10
(HP) (yield gpm)
electric
(type power)
- (7) electric log -
(yes or no)

(organization running log)

(8) how well bottom plugged and seal

DRILLERS REMARKS:


DEPT. OF NATURAL RESOURCES
BUREAU OF LAND & WATER RESOURCES

AUG 10 1983

RECEIVED

If well telescopes please sketch and show depths.

GROUND LEVEL

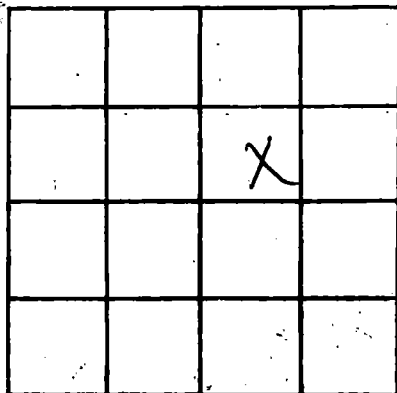

SECTION 22

Please indicate well location X.

ADDITIONAL INFORMATION

If more than one screen, show locations of each on sketch.