

MISSISSIPPI DEPARTMENT OF NATURAL RESOURCES

Bureau of Land and Water Resources

Southport Mall

P.O. Box 10631

Jackson, Mississippi 39209

WATER WELL DRILLERS LOG

Hancock  
K 2438

3-1- 1983 Ward Well Dlg. Hancock  
date well completed firm name county well located

LANDOWNER: Carl Hitzman

description of formations encountered

from to

Hwy 90  
 Waveland ms.  
(mailing address)

<u>Fill - clay</u>	<u>0</u>	<u>12</u>
<u>sd</u>	<u>12</u>	<u>54</u>
<u>Clay</u>	<u>54</u>	<u>66</u>
<u>sd</u>	<u>66</u>	<u>120</u>

WELL LOCATION:

sec. 35 T 8 N R 13 E 14 W  
2 miles E of Waveland  
(distance) (direction) (nearest town)

WELL PURPOSE: Heat Pump  
(home, irrigation, municipal, industrial)

WELL COMPLETION DATA:

(1) diameter (inches) 4" x 2"  
(2) total depth (feet) 120  
(3) static water level (feet) 12 below above top of ground.  
(4) casing PVC, 100'  
(material) (depth)

(size) If telescope see back.

(5) screen 20' -  
(length) (depth to top)  
2" PVC  
(size) (material)

(6) pump owner  
(HP) (yield gpm)  
(type power)

(7) electric log NO  
(yes or no)  
N/A  
(organization running log)

(8) how well bottom plugged BWV

DRILLERS REMARKS: Will used for Water Source Heat Pump.

DEPT. OF NATURAL RESOURCES  
BUREAU OF LAND & WATER RESOURCES

APR 22 1983


RECEIVED

If well telescopes please sketch and show depths.

GROUND LEVEL

100' - 4" PVC

2" x 20' PVC  
Screen

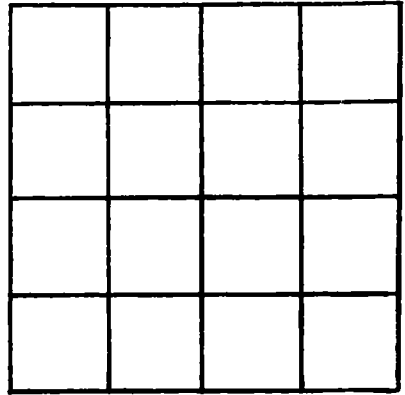

SECTION 35

Please indicate well location X.

ADDITIONAL INFORMATION

If more than one screen, show locations of each on sketch.