

MISSISSIPPI DEPARTMENT OF NATURAL RESOURCES

Bureau of Land and Water Resources

Southport Mall

P.O. Box 10631

Jackson, Mississippi 39209

WATER WELL DRILLERS LOG

Hancock  
K2440

3-8-  
date well completed

1983 Ward Well Dr.  
firm name

Hancock  
county well located

LANDOWNER: Frank Lacasse  
ave D.  
Bay St. Louis, ms.  
(mailing address)

description of formations encountered	from	to
<u>fill-clay</u>	<u>0</u>	<u>15</u>
<u>sd</u>	<u>15</u>	<u>46</u>
<u>clay-silt</u>	<u>46</u>	<u>105</u>
<u>fine sd</u>	<u>105</u>	<u>126</u>
<u>clay-silt</u>	<u>126</u>	<u>155</u>
<u>sd</u>	<u>155</u>	<u>170</u>

WELL LOCATION:  
sec. 40 T. 8 N. R. 13 E. 14  
9 miles N/W of Woodland  
(distance) (direction) (nearest town)

WELL PURPOSE: None  
(home, irrigation, municipal, industrial)

- WELL COMPLETION DATA:
- (1) diameter (inches) 2"
  - (2) total depth (feet) 170
  - (3) static water level (feet) 4 <sup>below</sup> above top of ground.
  - (4) casing PVC, 16.5  
(material) (depth)  
(size) If telescope see back.
  - (5) screen 5', -  
(length) (depth to top)  
2", PVC  
(size) (material)
  - (6) pump 1/2, 12  
(HP) (yield gpm)  
Elc.  
(type power)
  - (7) electric log NO  
(yes or no)  
N/A  
(organization running log)
  - (8) how well bottom plugged BWV

DRILLERS REMARKS: N/A


DEPT. OF NATURAL RESOURCES  
BUREAU OF LAND & WATER RESOURCES

APR 22 1983

RECEIVED

If well telescopes please sketch and show depths.

GROUND LEVEL

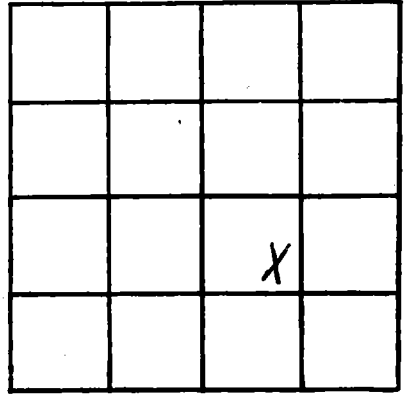

SECTION 40

Please indicate well location X.

ADDITIONAL INFORMATION

If more than one screen, show locations of each on sketch.