

MISSISSIPPI DEPARTMENT OF NATURAL RESOURCES

Bureau of Land and Water Resources

Southport Mall

P.O. Box 10631

Jackson, Mississippi 39209

WATER WELL DRILLERS LOG

Hancock  
K 2445

7-24 1983  
date well completed

Duncan Well Drilling  
firm name

Hancock  
county well located

LANDOWNER: Gilbert Speicher

description of formations encountered

from to

822 Hwy. 90 West

<u>Sand Soil</u>	<u>0</u>	<u>23</u>
<u>white &amp; blue clay</u>	<u>23</u>	<u>110</u>
<u>coarse sand</u>	<u>110</u>	<u>126</u>

Bay St. Louis Ms. 39520  
(mailing address)

WELL LOCATION:

sec 5 T 9 N R 14 E  
3 miles W of Waveland  
(distance) (direction) (nearest town)

WELL PURPOSE: Trailer Home  
(home, irrigation, municipal, industrial)

WELL COMPLETION DATA:

- (1) diameter (inches) 2"
- (2) total depth (feet) 126 ft.
- (3) static water level (feet) 8' <sup>below</sup> <sub>above</sub> top of ground. Flow
- (4) casing pvc, 116'  
(material) (depth)  
— If telescope see back.  
(size)
- (5) screen 10', 126'  
(length) (depth to top)  
2", pvc  
(size) (material)
- (6) pump 1 (HP) 8 (yield gpm)  
electric  
(type power)
- (7) electric log —  
(yes or no)

—  
(organization running log)

(8) how well bottom plugged Sand  
Mark

DRILLERS REMARKS:  
Installed owners pump


DEPT. OF NATURAL RESOURCES  
BUREAU OF LAND & WATER RESOURCES

AUG 19 1983

RECEIVED

If well telescopes please sketch and show depths.

GROUND LEVEL

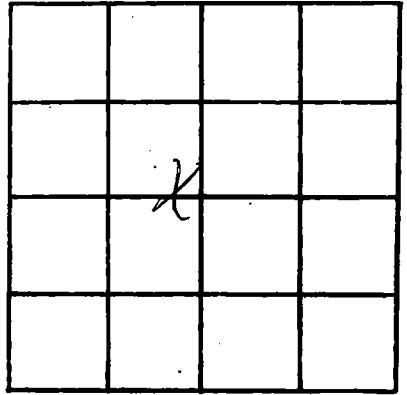

SECTION 5

Please indicate well location X.

ADDITIONAL INFORMATION

If more than one screen, show locations of each on sketch.