

MISSISSIPPI DEPARTMENT OF NATURAL RESOURCES

Bureau of Land and Water Resources

Southport Mall

P.O. Box 10631

Jackson, Mississippi 39209

WATER WELL DRILLERS LOG

Hancock
K 2447

5-3- 19 83 Ward Well Dlg. Hancock
date well completed firm name county well located

LANDOWNER	description of formations encountered	from	to
<u>Sherald Winkle</u>	<u>Fill - clay</u>	<u>0</u>	<u>18</u>
<u>Lake St.</u>	<u>sd</u>	<u>18</u>	<u>36</u>
<u>Bay St. Lavin ma.</u>	<u>clay</u>	<u>36</u>	<u>78</u>
(mailing address)	<u>sd</u>	<u>78</u>	<u>85</u>
WELL LOCATION:	<u>clay</u>	<u>85</u>	<u>110</u>
sec. <u>33</u> T <u>8</u> N R <u>14</u> E	<u>fine sd</u>	<u>110</u>	<u>124</u>
<u>2</u> miles <u>N</u> of <u>Wardland</u>	<u>clay</u>	<u>124</u>	<u>147</u>
(distance) (direction) (nearest town)	<u>sd</u>	<u>147</u>	<u>170</u>
WELL PURPOSE: <u>Home</u>			
(home, irrigation, municipal, industrial)			
WELL COMPLETION DATA:			
(1) diameter (inches) <u>2"</u>			
(2) total depth (feet) <u>170</u>			
(3) static water level (feet) <u>8</u> <u>below</u> top of ground. <u>above</u>			
(4) casing <u>PVC</u> , <u>160</u> (material) (depth)			
(size) If telescope see back.			
(5) screen <u>10'</u> , <u>-</u> (length) (depth to top)			
<u>2"</u> , <u>PVC</u> (size) (material)			
(6) pump <u>1/2</u> , <u>10</u> (HP) (yield gpm)			
<u>Elec.</u> (type power)			
(7) electric log <u>NO</u> (yes or no)			
<u>N/A</u> (organization running log)			
(8) how well bottom plugged <u>BWV</u>			
DRILLERS REMARKS: <u>N/A</u>			


DEPT. OF NATURAL RESOURCES
BUREAU OF LAND & WATER RESOURCES

JUN 17 1983

RECEIVED

If well telescopes please sketch and show depths.

GROUND LEVEL

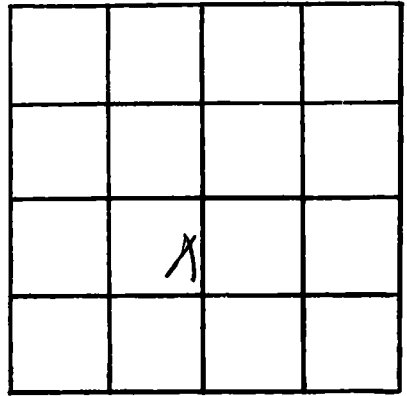

SECTION 33

Please indicate well location X.

ADDITIONAL INFORMATION

If more than one screen, show locations of each on sketch.