

MISSISSIPPI DEPARTMENT OF NATURAL RESOURCES

Bureau of Land and Water Resources

Southport Mall

P.O. Box 10631

Jackson, Mississippi 39209

WATER WELL DRILLERS LOG

Hancock  
K 2448

5-4-

1983 Ward Well Dr.

Hancock

date well completed

firm name

county well located

LANDOWNER John Oliver  
Rt. 4, Box 256 A  
Bay St. Louis, ms.  
(mailing address)

description of formations encountered

from

to

<u>Clay</u>	<u>0</u>	<u>12</u>
<u>sd</u>	<u>22</u>	<u>36</u>
<u>Clay</u>	<u>36</u>	<u>85</u>
<u>core sd</u>	<u>85</u>	<u>126</u>

WELL LOCATION:

sec. 22 T. 8 N. R. 13 E. 14  
3 miles N of B.S.L.  
(distance) (direction) (nearest town)

WELL PURPOSE:

(home, irrigation, municipal, industrial) Home

WELL COMPLETION DATA:

- (1) diameter (inches) 2"
- (2) total depth (feet) 126'
- (3) static water level (feet) 8 <sup>below</sup> above top of ground.
- (4) casing PVC, 116  
(material) (depth)  
— If telescope see back.  
(size)
- (5) screen 10  
(length) (depth to top)  
2" PVC  
(size) (material)
- (6) pump owner  
(HP) (yield gpm)  
—  
(type power)
- (7) electric log NO  
(yes or no)

(organization running log)

(8) how well bottom plugged N/A

DRILLERS REMARKS: BWV


DEPT. OF NATURAL RESOURCES  
BUREAU OF LAND & WATER RESOURCES

JUN 17 1983

RECEIVED

If well telescopes please sketch and show depths.

GROUND LEVEL

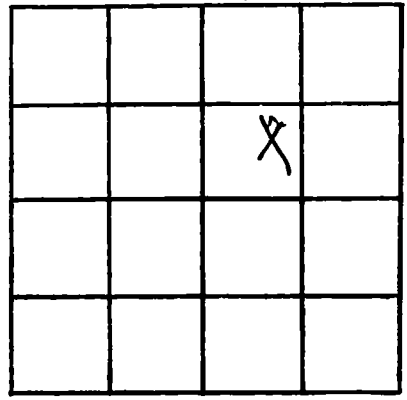

SECTION 22

Please indicate well location X.

ADDITIONAL INFORMATION

If more than one screen, show locations of each on sketch.