

MISSISSIPPI DEPARTMENT OF NATURAL RESOURCES

Bureau of Land and Water Resources

Southport Mall

P.O. Box 10631

Jackson, Mississippi 39209

WATER WELL DRILLERS LOG

Hancock
K 2452

5-18 1983 Ward Well Dr. Hancock
date well completed firm name county well located

LANDOWNER:	description of formations encountered	from	to
<u>Ed Hancock</u>			
<u>Erie + ave B,</u>	<u>Sandy Soil</u>	<u>0</u>	<u>4</u>
<u>Waveland, ms,</u>	<u>Clay</u>	<u>4</u>	<u>18</u>
(mailing address)	<u>sd</u>	<u>18</u>	<u>63</u>
	<u>Clay</u>	<u>63</u>	<u>85</u>
WELL LOCATION:	<u>sd</u>	<u>85</u>	<u>112</u>
sec. <u>33</u> T. <u>8</u> N. R. <u>13</u> E. <u>14</u>	<u>Clay</u>	<u>112</u>	<u>128</u>
<u>1</u> miles <u>N</u> of <u>Waveland</u>	<u>Coast sd</u>	<u>128</u>	<u>147</u>
(distance) (direction) (nearest town)			
WELL PURPOSE:			
(home, irrigation, municipal, industrial)			
WELL COMPLETION DATA:			
(1) diameter (inches) <u>2"</u>			
(2) total depth (feet) <u>147</u>			
(3) static water level (feet) <u>10</u> ^{below} top of ground			
(4) casing <u>PVC</u> <u>137</u> (material) (depth)			
(size) if telescope see back.			
(5) screen <u>10'</u> <u>-</u> (length) (depth to top)			
<u>2"</u> <u>PVC</u> (size) (material)			
(6) pump <u>owner</u> (HP) (yield gpm)			
(type power)			
(7) electric log <u>NO</u> (yes or no)			
<u>N/A</u> (organization running log)			
(8) how well bottom plugged <u>BWU</u>			
DRILLERS REMARKS: <u>N/A</u>			


DEPT. OF NATURAL RESOURCES
BUREAU OF LAND & WATER RESOURCES

JUL 5 1983

RECEIVED

If well telescopes please sketch and show depths.

GROUND LEVEL

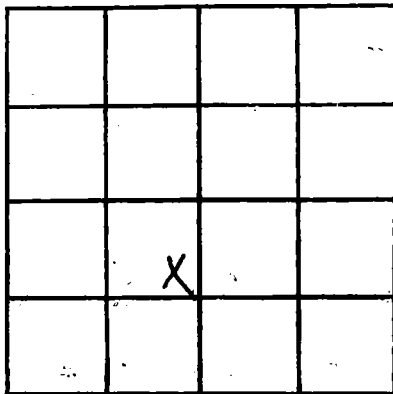

SECTION 33

Please indicate well location X.

ADDITIONAL INFORMATION

If more than one screen,
show locations of each on sketch.