

MISSISSIPPI DEPARTMENT OF NATURAL RESOURCES

Bureau of Land and Water Resources

Southport Mall

P.O. Box 10631

Jackson, Mississippi 39209

WATER WELL DRILLERS LOG

Hancock
K2457

6/1/83 date well completed Graden Pump & Well Sew. Inc. firm name Hancock county well located

LANDOWNER: Gerald Cratwell
Rt. 2, Box 576 P
Bay St. Louis, Mo.
 (mailing address) 39520

description of formations encountered	from	to
<u>clay</u>	<u>0</u>	<u>10</u>
<u>sand</u>	<u>10</u>	<u>50</u>
<u>clay</u>	<u>50</u>	<u>60</u>
<u>sand</u>	<u>60</u>	<u>80</u>
<u>clay</u>	<u>80</u>	<u>100</u>
<u>sand</u>	<u>100</u>	<u>140</u>
<u>clay</u>	<u>140</u>	<u>155</u>
<u>sand</u>	<u>155</u>	<u>180</u>

WELL LOCATION:
 sec. 9 T. 9 R. 14 (14W)
in miles Bay St Louis
 (distance) (direction) (nearest town)

WELL PURPOSE: None
 (home, irrigation, municipal, industrial)

WELL COMPLETION DATA:

(1) diameter (inches) 2"

(2) total depth (feet) 180

(3) static water level (feet) 12 below top of ground.

(4) casing PVC, 160
 (material) (depth)

(size) if telescope see back.

(5) screen 10', 160
 (length) (depth to top)

2", PVC
 (size) (material)

(6) pump 1/2, 10
 (HP) (yield gpm)

230V
 (type power)

(7) electric log no
 (yes or no)

(organization running log)

(8) how well bottom plugged PVC sandstone

DRILLERS REMARKS: 10 ft tailpipe


DEPT. OF NATURAL RESOURCES
 BUREAU OF LAND & WATER RESOURCES

JUN 19 1983

RECEIVED

If well telescopes please sketch and show depths.

GROUND LEVEL

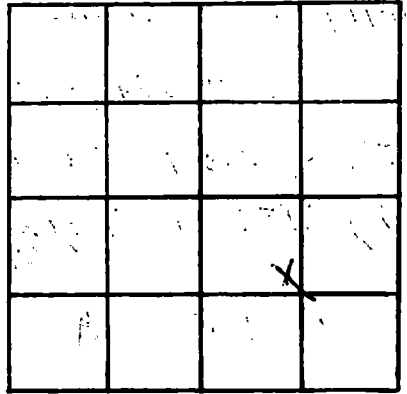

SECTION 9

Please indicate well location X.

ADDITIONAL INFORMATION

If more than one screen, show locations of each on sketch.