

MISSISSIPPI DEPARTMENT OF NATURAL RESOURCES

Bureau of Land and Water Resources

Southport Mall

P.O. Box 10631

Jackson, Mississippi 39209

WATER WELL DRILLERS LOG

POUNCEY WATER WELL DRILLING

Hancock
K 2460

Hancock

6-4 1983 firm name county well located

LANDOWNER: J.L. Wells -
Arizona St.
Shore Line Park.
(mailing address)

description of formations encountered	from	to
	<u>fill</u>	<u>0</u>

WELL LOCATION:
sec 28 T 8 N R 14 E
(S) (W)
2 miles N of Waldport
(distance) (direction) (nearest town)

<u>Marsh Clay grass</u>	<u>6</u>	<u>14</u>
<u>sd.</u>	<u>14</u>	<u>68</u>
<u>Clay Blue</u>	<u>68</u>	<u>155</u>

WELL PURPOSE: Camp
(home, irrigation, municipal, industrial)

<u>set.</u>	<u>155</u>	<u>176</u>
-------------	------------	------------

WELL COMPLETION DATA:

(1) diameter (inches) 2

(2) total depth (feet) 190

(3) static water level (feet) 6' below top of ground. above

(4) casing PVC 180
(material) (depth)
2 if telescope see back.
(size)

(5) screen 10 180
(length) (depth to top)
2 PVC
(size) (material)

(6) pump 1/2 10
(HP) (yield gpm)
AC
(type power)

(7) electric log /
(yes or no)
(organization running log)

(8) how well bottom plugged Seal

<u>set to fine sd.</u>	<u>176</u>	<u>190</u>
------------------------	------------	------------

DEPT. OF NATURAL RESOURCES
BUREAU OF LAND & WATER RESOURCES


AUG 26 1983

RECEIVED

DRILLERS REMARKS:

If well telescopes please sketch and show depths.

GROUND LEVEL

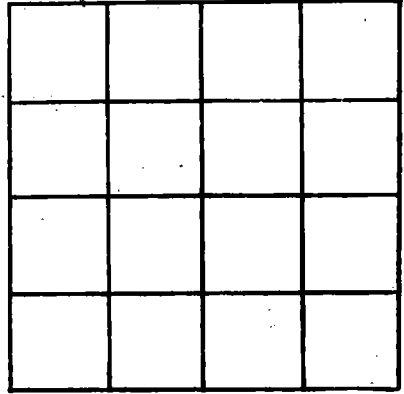

SECTION _____

Please indicate well location X.

ADDITIONAL INFORMATION

If more than one screen, show locations of each on sketch.