

MISSISSIPPI DEPARTMENT OF NATURAL RESOURCES

Bureau of Land and Water Resources

Southport Mall

P.O. Box 10631

Jackson, Mississippi 39209

WATER WELL DRILLERS LOG

Hancock
K 2461

6-9-83 date well completed Gulf Coast Waterwell firm name Hancock county well located

LANDOWNER: Vincent Messina
WOODLAWN
35 W [unclear]
Northaven La 20047
 (mailing address)

description of formations encountered	from	to
Top Soil Clay	-	12
Sand	12	118
Clay	118	122
Sand (med.)	122	208

WELL LOCATION:
 sec. 22 T. 8 S. R. 14 E. W.
3 miles NW of Bay St Louis
 (distance) (direction) (nearest town)

WELL PURPOSE: Summer Home
 (home, irrigation, municipal, industrial)

WELL COMPLETION DATA:

(1) diameter (inches) 2

(2) total depth (feet) 208

(3) static water level (feet) 7 below ~~above~~ top of ground.

(4) casing PVC, 180
 (material) (depth)
 (size) If telescope see back.

(5) screen 20, 180
 (length) (depth to top)
2", PVC
 (size) (material)

(6) pump 1, 12
 (HP) (y/d gpm)
220 VAC
 (type power)

(7) electric log NO
 (yes or no)
 (organization running log)

(8) how well bottom plugged Sand Shuck

DEPT. OF NATURAL RESOURCES
 BUREAU OF LAND & WATER RESOURCES


JUN 16 1983

RECEIVED

DRILLERS REMARKS:

If well telescopes please sketch and show depths.

GROUND LEVEL

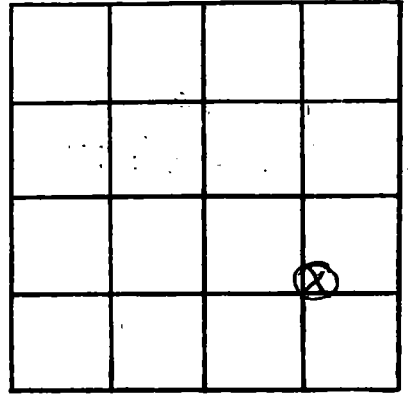

SECTION 22

Please indicate well location X.

ADDITIONAL INFORMATION

If more than one screen, show locations of each on sketch.