

MISSISSIPPI DEPARTMENT OF NATURAL RESOURCES
Bureau of Land and Water Resources
 Southport Mall
 P.O. Box 10631
 Jackson, Mississippi 39209
WATER WELL DRILLERS LOG

Hancock
K 24/62

6-10 1983 WARD WELL D.L.G. Hancock
 date well completed firm name county well located

LANDOWNER: Johnny Adams
Sogan St.
Box St. Louis, mo.
 (mailing address)

description of formations encountered	from to	
<u>fill - clay</u>	<u>0</u>	<u>15</u>
<u>sd</u>	<u>15</u>	<u>45</u>
<u>clay</u>	<u>45</u>	<u>104</u>
<u>fine sd</u>	<u>104</u>	<u>123</u>
<u>clay-silt</u>	<u>123</u>	<u>180</u>
<u>crs sd</u>	<u>180</u>	<u>201</u>

WELL LOCATION:
 sec. 40 T. 8 N. R. 13 E. 14
5 miles N of Wardlaw
 (distance) (direction) (nearest town)

WELL PURPOSE: Comp
 (home, irrigation, municipal, industrial)

- WELL COMPLETION DATA:
- (1) diameter (inches) 2"
 - (2) total depth (feet) 201
 - (3) static water level (feet) 1 ^{below} _{above} top of ground.
 - (4) casing PVC, 191,
 (material) (depth)
 (size) if telescope see back.
 - (5) screen 10', -
 (length) (depth to top)
2", PVC
 (size) (material)
 - (6) pump 1/2, 10
 (HP) (yield gpm)
Elec.
 (type power)
 - (7) electric log NO
 (yes or no)
N/A
 (organization running log)
 - (8) how well bottom plugged BWD

DRILLERS REMARKS: N/A


DEPT. OF NATURAL RESOURCES
 BUREAU OF LAND & WATER RESOURCES

JUL 25 1983

RECEIVED

If well telescopes please sketch and show depths.

GROUND LEVEL

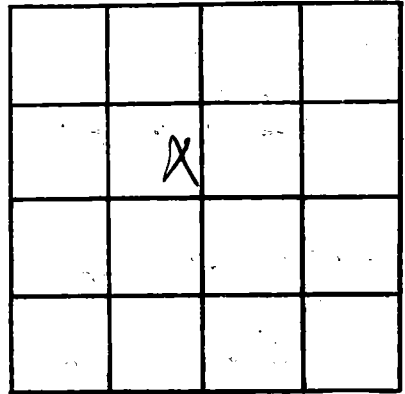

SECTION 5

Please indicate well location X.

ADDITIONAL INFORMATION

If more than one screen, show locations of each on sketch.