

MISSISSIPPI DEPARTMENT OF NATURAL RESOURCES

Bureau of Land and Water Resources

Southport Mall

P.O. Box 10631

Jackson, Mississippi 39209

WATER WELL DRILLERS LOG

Hancock  
K 2465

C-28 1983 Wood Well Dr. Hancock  
date well completed firm name county well located

LANDOWNER: Jack Parker  
1 Hollywood Drive  
Bay St. Louis, Ms.  
(mailing address)

description of formations encountered	from	to
<u>Fill - clay</u>	<u>0</u>	<u>25</u>
<u>sd</u>	<u>25</u>	<u>48</u>
<u>gravel</u>	<u>48</u>	<u>70</u>
<u>sd</u>	<u>70</u>	<u>126</u>
<u>clay-silt</u>	<u>126</u>	<u>245</u>
<u>fine-sd</u>	<u>245</u>	<u>288</u>
<u>clay-silt</u>	<u>288</u>	<u>372</u>
<u>sd</u>	<u>372</u>	<u>424</u>
<u>clay-silt</u>	<u>424</u>	<u>512</u>
<u>coar. sl</u>	<u>512</u>	<u>567</u>

WELL LOCATION:  
sec. 42 T. 8 N. R. 13 E. 14  
3 1/2 miles N/W of B.S.L.  
(distance) (direction) (nearest town)

WELL PURPOSE: Home  
(home, irrigation, municipal, industrial)

WELL COMPLETION DATA:

(1) diameter (inches) 2"

(2) total depth (feet) 567

(3) static water level (feet) 10 below top of ground. (above)

(4) casing PVC, 547,  
(material) (depth)

- if telescope see back.  
(size)

(5) screen 20, -  
(length) (depth to top)

2", PVC  
(size) (material)

(6) pump 1/2, 10  
(HP) (yield gpm)

elec.  
(type power)

(7) electric log NO  
(yes or no)

N/A  
(organization running log)

(8) how well bottom plugged BWV

DRILLERS REMARKS: N/A


DEPT. OF NATURAL RESOURCES  
BUREAU OF LAND & WATER RESOURCES

JUL 25 1983

RECEIVED

If well telescopes please sketch and show depths.

GROUND LEVEL

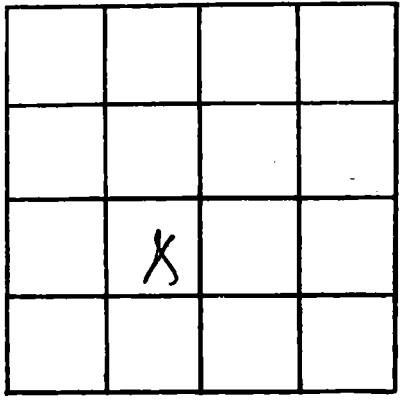

SECTION \_\_\_\_\_

Please indicate well location X.

ADDITIONAL INFORMATION

Lined area for additional information.

If more than one screen, show locations of each on sketch.