

MISSISSIPPI DEPARTMENT OF NATURAL RESOURCES

Bureau of Land and Water Resources

Southport Mall

P.O. Box 10631

Jackson, Mississippi 39209

WATER WELL DRILLERS LOG

Hancock
K 2466

8 Sept.

1983

Ward Well Drg.

Hancock

date well completed

firm name

county well located

LANDOWNER: Bill Dawson

Dezas St.

description of formations encountered

fill - clay

from

to

0 16

Bay St. Louis, Miss.
(mailing address)

sd
clay - silt

16 48

WELL LOCATION:

sec. 40 T. 8 N. R. 124 E.

fine sd
clay - silt
sd

48 104

104 118

118 322

322 357

6 miles N of Waveland
(distance) (direction) (nearest town)

WELL PURPOSE: none
(home, irrigation, municipal, industrial)

WELL COMPLETION DATA:

(1) diameter (inches) 2"
(2) total depth (feet) 357

(3) static water level (feet) 1 below above
top of ground.

(4) casing PVC, 347,
(material) (depth)

- if telescope see back.
(size)

(5) screen 10', -
(length) (depth to top)

2", PVC
(size) (material)

(6) pump none, -
(HP) (yield gpm)

-
(type power)

(7) electric log no
(yes or no)

MIT
(organization running log)

(8) how well bottom plugged BWU

DRILLERS REMARKS: N/A


DEPT. OF NATURAL RESOURCES
BUREAU OF LAND & WATER RESOURCES

NOV - 3 1983

RECEIVED

If well telescopes please sketch and show depths.

GROUND LEVEL

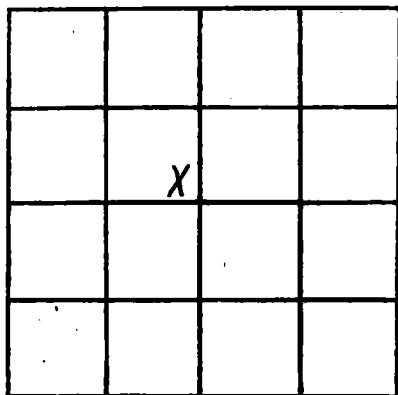

SECTION 40

Please indicate well location X.

ADDITIONAL INFORMATION

If more than one screen, show locations of each on sketch.