

MISSISSIPPI DEPARTMENT OF NATURAL RESOURCES

Bureau of Land and Water Resources

Southport Mall

P.O. Box 10631

Jackson, Mississippi 39209

WATER WELL DRILLERS LOG

Hancock
R 2467

July 5 1983 Duncan Well Drilling Hancock
 date well completed firm name county well located

LANDOWNER: Sony Angresano
5136 Oak Dr.
Marrero, LA 70072
 (mailing address)

description of formations encountered	from	to
	<u>Clay</u>	<u>0</u>
<u>Sand</u>	<u>45</u>	<u>60</u>

WELL LOCATION:
 sec. 5 T 9 N R 14 E
3 miles W of Waveland
 (distance) (direction) (nearest town)

WELL PURPOSE: Camp
 (home, irrigation, municipal, industrial)

- WELL COMPLETION DATA:
- (1) diameter (inches) 2"
 - (2) total depth (feet) 60'
 - (3) static water level (feet) 8' below above top of ground.
 - (4) casing PVC 50'
 (material) (depth)
 (size) If telescope see back.
 - (5) screen 10' 50'
 (length) (depth to top)
2" PVC
 (size) (material)
 - (6) pump 1 8
 (HP) (yield gpm)
 (type power)
 - (7) electric log
 (yes or no)
 (organization running log)
 - (8) how well bottom plugged Sand
Shark

DRILLERS REMARKS:


DEPT. OF NATURAL RESOURCES
 BUREAU OF LAND & WATER RESOURCES

AUG 15 1983

RECEIVED

If well telescopes please sketch and show depths.

GROUND LEVEL

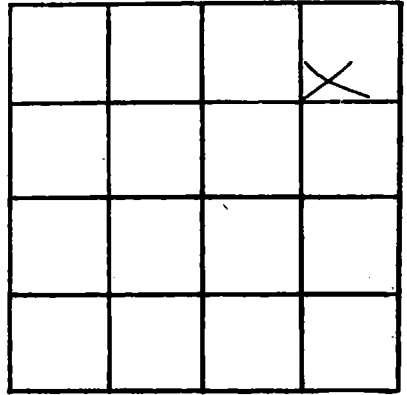

SECTION 5

Please indicate well location X.

ADDITIONAL INFORMATION

If more than one screen,
show locations of each on sketch.