

MISSISSIPPI DEPARTMENT OF NATURAL RESOURCES

Bureau of Land and Water Resources

Southport Mall

P.O. Box 10631

Jackson, Mississippi 39209

WATER WELL DRILLERS LOG

Hancock
R 2469

July 6 1983 Duncan Well Drilling Hancock
 date well completed firm name county well located

LANDOWNER: Geat Short
3214 Slidell Ave
Slidell, La.
 (mailing address)

description of formations encountered	from	to
	<u>sand</u>	<u>0</u>
<u>blue clay</u>	<u>10</u>	<u>80</u>
<u>good sand</u>	<u>80</u>	<u>100</u>

WELL LOCATION:
 sec 24 T 8 N R 14 E
5 miles N. of Woodland
 (distance) (direction) (nearest town)

WELL PURPOSE: Wash-end (camp)
 (home, irrigation, municipal, industrial)

- WELL COMPLETION DATA:
- (1) diameter (inches) 2"
 - (2) total depth (feet) 100 ft
 - (3) static water level (feet) 70' below above top of ground.
 - (4) casing PVC 90
 (material) (depth)
 (size) If telescope see back.
 - (5) screen 10' 90'
 (length) (depth to top)
2" PVC
 (size) (material)
 - (6) pump _____ (HP) _____ (yield gpm)
 (type power)
 - (7) electric log _____ (yes or no)
 (organization running log)
 - (8) how well bottom plugged _____

DEPT. OF NATURAL RESOURCES
 BUREAU OF LAND & WATER RESOURCES


AUG 15 1983

RECEIVED

DRILLERS REMARKS: Owner
had his own
pump

If well telescopes please sketch and show depths.

GROUND LEVEL

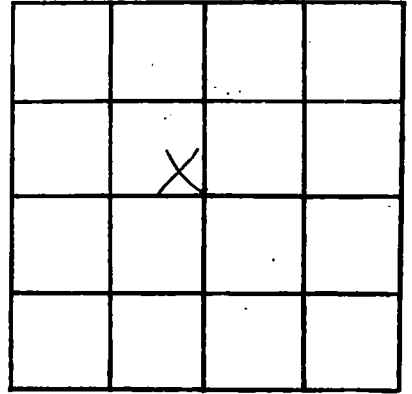

SECTION 24

Please indicate well location X.

ADDITIONAL INFORMATION

If more than one screen, show locations of each on sketch.