

MISSISSIPPI DEPARTMENT OF NATURAL RESOURCES

Bureau of Land and Water Resources

Southport Mall

P.O. Box 10631

Jackson, Mississippi 39209

WATER WELL DRILLERS LOG

Hancock  
K2471

7-8-

1983 Wood Well Drg.

Hancock

date well completed

firm name

county well located

LANDOWNER: J. K. Conzelmann

description of formations encountered

from

to

St. 4, Box 429

fill - clay

0 18

Box St. Louis, mo.  
(mailing address)

sd

18 47

clay

47 58

sd

58 88

clay - silt

88 105

fine sd

105 116

clay silt

116 148

fine sd

148 166

clay - silt

166 325

sd

325 420

WELL LOCATION:

sec. 27 T. 8 N. R. 13 E.  
5 1/2 miles N/W of B.S.L.  
(distance) (direction) (nearest town)

WELL PURPOSE:

(home, irrigation, municipal, industrial) Home

WELL COMPLETION DATA:

- (1) diameter (inches) 2"
- (2) total depth (feet) 430
- (3) static water level (feet) 1 below top of ground.

- (4) casing PVC 400  
(material) (depth)

- if telescope see back.  
(size)

- (5) screen 20' -  
(length) (depth to top)
- 2" PVC  
(size) (material)

- (6) pump owner -  
(HP) (yield gpm)

-  
(type power)

- (7) electric log N/A  
(yes or no)

N/A  
(organization running log)

- (8) how well bottom plugged BWV

DRILLERS REMARKS: N/A


DEPT. OF NATURAL RESOURCES  
BUREAU OF LAND & WATER RESOURCES

AUG 17 1983

RECEIVED

If well telescopes please sketch and show depths.

GROUND LEVEL

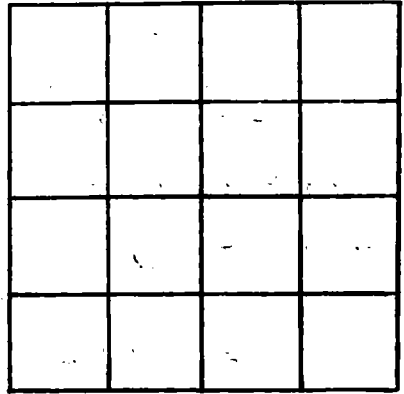

SECTION \_\_\_\_\_

Please indicate well location X.

ADDITIONAL INFORMATION

If more than one screen, show locations of each on sketch.