

MISSISSIPPI DEPARTMENT OF NATURAL RESOURCES

Bureau of Land and Water Resources

Southport Mall

P.O. Box 10631

Jackson, Mississippi 39209

WATER WELL DRILLERS LOG

Hancock
K 2474

7-18 1983 Wood Well Drg. Hancock
date well completed firm name county well located

LANDOWNER: Jane Smith
Saleshne Rd.
Saleshne, ms.
(mailing address)

description of formations encountered	from	to
<u>clay</u>	<u>0</u>	<u>18</u>
<u>clay sd</u>	<u>18</u>	<u>47</u>
<u>clay shell</u>	<u>47</u>	<u>84</u>
<u>Coarse sd - Red haul</u>	<u>84</u>	<u>99</u>
	<u>99</u>	<u>128</u>

WELL LOCATION:
20 sec 13 T 9 N R 14 E
12 miles S/W of Warland
(distance) (direction) (nearest town)

WELL PURPOSE: None
(home, irrigation, municipal, industrial)

- WELL COMPLETION DATA:
- (1) diameter (Inches) 2"
 - (2) total depth (feet) 128
 - (3) static water level (feet) 10 below top of ground.
 - (4) casing PVC, 118
(material) (depth)
 - (size) If telescope see back.
 - (5) screen 10', -
(length) (depth to top)
 - 2", PVC
(size) (material)
 - (6) pump 1/2, 10
(HP) (yield gpm)
 - elec.
(type power)
 - (7) electric log NO
(yes or no)
 - N/A
(organization running log)
 - (8) how well bottom plugged BWU

DRILLERS REMARKS: N/A


DEPT. OF NATURAL RESOURCES
BUREAU OF LAND & WATER RESOURCES

SEP 15 1983

RECEIVED

If well telescopes please sketch and show depths.

GROUND LEVEL

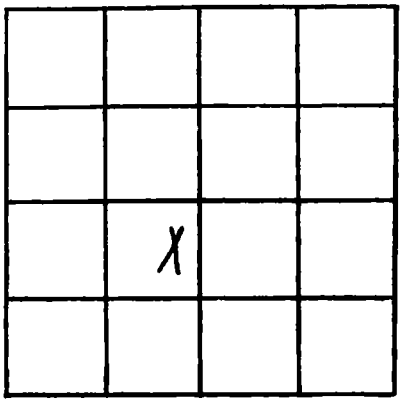

SECTION 13

Please indicate well location X.

ADDITIONAL INFORMATION

Lined area for additional information.

If more than one screen, show locations of each on sketch.