

MISSISSIPPI DEPARTMENT OF NATURAL RESOURCES

Bureau of Land and Water Resources

Southport Mall

P.O. Box 10631

Jackson, Mississippi 39209

WATER WELL DRILLERS LOG

Hancock
K 2478

July 28 1983 Duncan Well Drilling Hancock
date well completed firm name county well located

LANDOWNER: Deva Counce
Rt. 2 Box 632 E
Bay St. Louis Ms.
(mailing address)

description of formations encountered	depth	
	from	to
<u>Top Sand</u>	<u>0</u>	<u>20</u>
<u>Sandy, Red & Blue Clay</u>	<u>20</u>	<u>110</u>
<u>Course Sand</u>	<u>110</u>	<u>126</u>

WELL LOCATION:
sec 24 T 8 N 3 R 14 E W
5 miles N. of Waveland
(distance) (direction) (nearest town)

WELL PURPOSE: Home
(home, irrigation, municipal, industrial)

WELL COMPLETION DATA:

(1) diameter (inches) 2"

(2) total depth (feet) 126 ft.

(3) static water level (feet) 25 ^{below} ~~above~~ top of ground.

(4) casing PVC, 116,
(material) (depth)
 if telescope see back.
(size)

(5) screen 10', 116
(length) (depth to top)
2", PVC
(size) (material)

(6) pump _____ (HP) _____ (yield gpm)
(type power)

(7) electric log _____ (yes or no)
(organization running log)

(8) how well bottom plugged sand
chard

DEPT. OF NATURAL RESOURCES
BUREAU OF LAND & WATER RESOURCES


AUG 15 1983

RECEIVED

DRILLERS REMARKS:
owner had his own pump

If well telescopes please sketch and show depths.

GROUND LEVEL

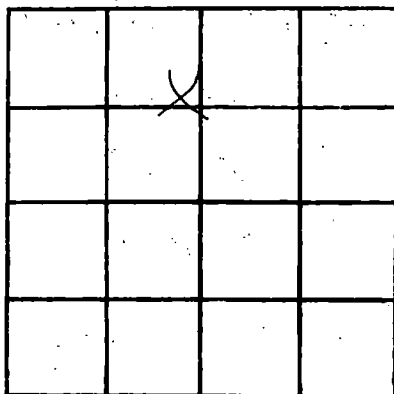

SECTION 24

Please indicate well location X.

ADDITIONAL INFORMATION

If more than one screen,
show locations of each on sketch.