

MISSISSIPPI DEPARTMENT OF NATURAL RESOURCES

Bureau of Land and Water Resources

Southport Mall

P.O. Box 10631

Jackson, Mississippi 39209

WATER WELL DRILLERS LOG

12

Duncan  
K2479

July 29 1983 Duncan Well Drilling Hancock  
date well completed firm name county well located

LANDOWNER: J.A. Hernandez  
Lake Drive  
Bay St. Louis Mo.  
(mailing address)

description of formations encountered	from	to
<u>Top Sand</u>	<u>0</u>	<u>60</u>
<u>Mixed Clay</u>	<u>60</u>	<u>95</u>
<u>Blue Clay</u>	<u>95</u>	<u>275</u>
<u>Fine Sand</u>	<u>275</u>	<u>304</u>
<u>Blue Clay</u>	<u>304</u>	<u>350</u>
<u>Course Sand</u>	<u>350</u>	<u>380</u>

WELL LOCATION:  
sec. 35 T 9 N R 13 E 14 W  
In Bay St. Louis  
(distance) miles (direction) (nearest town)

WELL PURPOSE:  
(home, irrigation, municipal, industrial)

WELL COMPLETION DATA:

(1) diameter (inches) 2"

(2) total depth (feet) 380 ft.

(3) static water level (feet) 33 below/above top of ground.

(4) casing pvc (material) 370' (depth)  
(size) If telescope see back.

(5) screen 10' (length) 370' (depth to top)  
2" (size) pvc (material)

(6) pump (HP) (yield gpm)  
(type power)

(7) electric log (yes or no)  
(organization running log)

(8) how well bottom plugged

DEPT. OF NATURAL RESOURCES  
BUREAU OF LAND & WATER RESOURCES


AUG 15 1983

RECEIVED

DRILLERS REMARKS: No  
pump installed

If well telescopes please sketch and show depths.

GROUND LEVEL

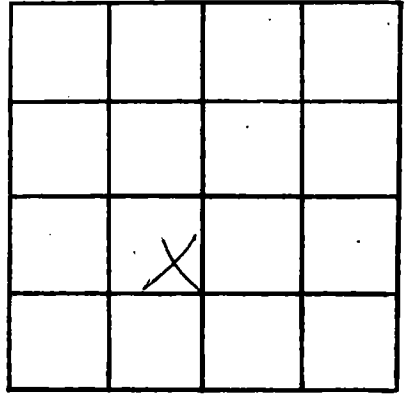

SECTION 35

Please indicate well location X.

ADDITIONAL INFORMATION

If more than one screen,  
show locations of each on sketch.