

MISSISSIPPI DEPARTMENT OF NATURAL RESOURCES

Bureau of Land and Water Resources

Southport Mall

P.O. Box 10631

Jackson, Mississippi 39209

WATER WELL DRILLERS LOG

Hancock
K 22480

Aug 6
 (date well completed)

Mc Gill Well Works
 firm name

Hancock
 county well located

LANDOWNER: CARL HEITZMAN

PO Box 1256

BAY ST. LOUIS
 (mailing address)

WELL LOCATION:

sec. 10 T. 9 N. R. 14 E.
3 miles (distance) E (direction) of BSL (nearest town)

WELL PURPOSE: IRIGATION
 (home, irrigation, municipal, industrial)

WELL COMPLETION DATA:

- (1) diameter (inches) 4 inch
- (2) total depth (feet) 180
- (3) static water level (feet) 10 ^{below} _{above} top of ground. 40' PVC
- (4) casing Plastic (material), 180 (depth)

(size) If telescope see back.

- (5) screen 10 ft. (Length), 170 (depth to top)

(size) Plastic sch 40 (material)

- (6) pump 1/2 sub. (HP), 20 (yield gpm)

Flac (type power)

- (7) electric log NO (yes or no)

(organization running log)

- (8) how well bottom plugged Shark

description of formations encountered

from to

SAND	0	20
SAND	20	40
SAND	40	60
mud	60	140
mud + sand	140	160
SAND	160	180

DRILLERS REMARKS:

DEPT. OF NATURAL RESOURCES
 BUREAU OF LAND & WATER RESOURCES

JAN 17 1984

RECEIVED

If well telescopes please sketch and show depths.


GROUND LEVEL

EAST-W 11

W 1' 0" DIA

01 03
01 05
01 07
01 09
01 11
01 13
01 15

01 03
01 05
01 07
01 09
01 11
01 13
01 15

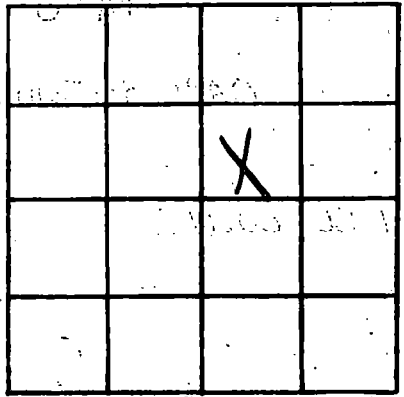

SECTION 10

Please indicate well location X.

ADDITIONAL INFORMATION

01 03

01 05

01 07

01 99

If more than one screen, show locations of each on sketch.