

MISSISSIPPI DEPARTMENT OF NATURAL RESOURCES

Bureau of Land and Water Resources

Southport Mall

P.O. Box 10631

Jackson, Mississippi 39209

WATER WELL DRILLERS LOG

Hancock  
K 2482

8-11-1983 date well completed Ward Well Pkg. firm name Hancock county well located

LANDOWNER:	description of formations encountered	from	to
<u>Frank Carter</u> <u>ave D,</u>			
<u>Bay St. Louis ms.</u> (mailing address)	<u>sd</u> <u>clay - fill</u>	<u>15</u>	<u>46</u>
	<u>fine sd</u>	<u>46</u>	<u>105</u>
	<u>clay - fill</u>	<u>105</u>	<u>116</u>
	<u>sd</u>	<u>116</u>	<u>152</u>
		<u>152</u>	<u>170</u>

WELL LOCATION:  
sec. 27 T. 8 N R. 13 E 14  
6 miles N of Waveland  
(distance) (direction) (nearest town)

WELL PURPOSE: drine  
(home, irrigation, municipal, industrial)

- WELL COMPLETION DATA:
- (1) diameter (inches) 2"
  - (2) total depth (feet) 170
  - (3) static water level (feet) 4 <sup>below</sup> <sub>above</sub> top of ground.
  - (4) casing PVC, 160,  
(material) (depth)  
- if telescope see back.  
(size)
  - (5) screen 10', -  
(length) (depth to top)  
2", PVC  
(size) (material)
  - (6) pump runner, -  
(HP) (yield gpm)  
-  
(type power)
  - (7) electric log no  
(yes or no)  
N/A  
(organization running log)
  - (8) how well bottom plugged BWD

DRILLERS REMARKS: N/A


DEPT. OF NATURAL RESOURCES  
BUREAU OF LAND & WATER RESOURCES

SEP 15 1983

RECEIVED

If well telescopes please sketch and show depths.

GROUND LEVEL

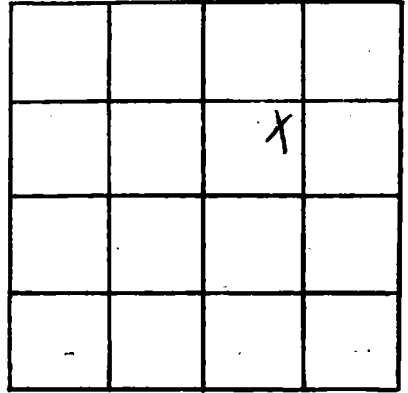

SECTION 27

Please indicate well location X.

ADDITIONAL INFORMATION

If more than one screen,  
show locations of each on sketch.