

MISSISSIPPI DEPARTMENT OF NATURAL RESOURCES

Bureau of Land and Water Resources

Southport Mall

P.O. Box 10631

Jackson, Mississippi 39209

WATER WELL DRILLERS LOG

HANCOCK
K 2484

Aug. 22 1983 Duncan Well Drilling Hancock
date well completed firm name county well located

LANDOWNER: Luzanna Hughes
Rt. 2
Bay St. Louis, Ms.
(mailing address)

description of formations encountered	from	to
<u>Top Sand</u>	<u>0</u>	<u>40</u>
<u>Sandy, Red & Blue clay</u>	<u>40</u>	<u>130</u>
<u>Coarse Sand</u>	<u>130</u>	<u>150</u>

WELL LOCATION:
sec 24 T 8 N R 14 E
5 miles N. of Stennis
(distance) (direction) (nearest town)

WELL PURPOSE: Home
(home, irrigation, municipal, industrial)

WELL COMPLETION DATA:

(1) diameter (inches) 2"

(2) total depth (feet) 150'

(3) static water level (feet) 25' below above top of ground.

(4) casing PVC, 140'
(material) (depth)

 If telescope see back.
(size)

(5) screen 10', 140'
(length) (depth to top)

2", PVC
(size) (material)

(6) pump _____ (HP) _____ (yield gpm)

_____ (type power)

(7) electric log (yes or no)

_____ (organization running log)

(8) how well bottom plugged sand

DRILLERS REMARKS: Owner
Had his own
pump


DEPT. OF NATURAL RESOURCES
BUREAU OF LAND & WATER RESOURCES

FEB 10 1984

RECEIVED

If well telescopes please sketch and show depths.

GROUND LEVEL

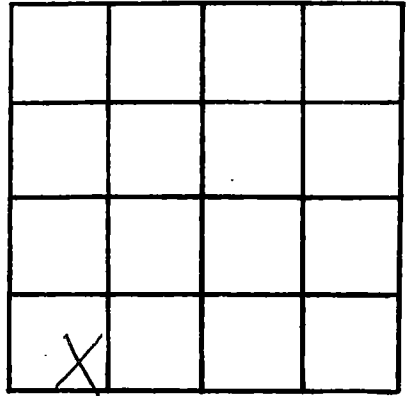

SECTION 24

Please indicate well location X.

ADDITIONAL INFORMATION

If more than one screen,
show locations of each on sketch.