

Zancock
K 2488
3/4/

MISSISSIPPI
 BOARD OF WATER COMMISSIONERS
 416 North State Street
 Jackson, Mississippi 39201

WATER WELL DRILLERS LOG

March 4 1974 Fare well work Hancock
 date well completed firm name county well located

LANDOWNER: Mrs. Harold
Quider
Box Bb, Lenoir Miss
 (mailing address)

WELL LOCATION:
 sec. 37 T. 8 N. R. 14 E
6 miles E of B.S.L.
 (distance) (direction) (nearest town)

WELL PURPOSE:
 (home, irrigation, municipal, industrial)

WELL COMPLETION DATA:

(1) diameter (inches) 2"

(2) total depth (feet) 90

(3) static water level (feet) 7 below above top of ground.

(4) casing Plastic 90
 (material) (depth)

(size) If telescope see back.

(5) screen 5 90
 (length) (depth to top)

2 Plastic
 (size) (material)

(6) pump 1/2 5
 (HP) (yield gpm)

Elect.
 (type power)

(7) electric log (yes or no)

(organization running log)

(8) how well bottom plugged B.W.U.

description of formations encountered	from	to
Black mud	0	10
Red clay	10	20
Sand	20	30
Sand & gravel	30	40
Sand & gravel	40	50
Blue clay	60	60
Blue clay	60	70
Blue clay	70	80
sand	80	90


DRILLERS REMARKS:

RECEIVED
 MAR 16 1974

MISS. BD. OF WATER COMM

If well telescopes please sketch and show depths.

GROUND LEVEL

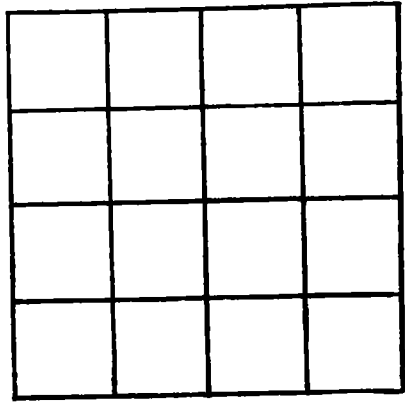

SECTION _____

Please indicate well location X.

ADDITIONAL INFORMATION

If more than one screen, show locations of each on sketch.