

MISSISSIPPI DEPARTMENT OF NATURAL RESOURCES
Bureau of Land and Water Resources
 Southport Mall
 P.O. Box 10631
 Jackson, Mississippi 39209
WATER WELL DRILLERS LOG

HANCOCK
K2494

10-17- 1983 Ward Well Dlg. Hancock
 date well completed firm name county well located

LANDOWNER: Charlie Duffy
Hancock & Jackson St.
Bay St. Louis, ms.
 (mailing address)

description of formations encountered	from	to
	<u>Fill - clay</u>	<u>0</u>
<u>sd</u>	<u>12</u>	<u>44</u>
<u>clay</u>	<u>44</u>	<u>105</u>
<u>sd</u>	<u>105</u>	<u>128</u>
<u>clay</u>	<u>128</u>	<u>157</u>
<u>Red Shale - sd</u>	<u>157</u>	<u>177</u>

WELL LOCATION:
 sec. 6 T 9 N R. 14 E
8 miles N/W of Ward
 (distance) (direction) (nearest town)

WELL PURPOSE: Home
 (home, irrigation, municipal, industrial)

WELL COMPLETION DATA:

(1) diameter (inches) 2"
 (2) total depth (feet) 177
 (3) static water level (feet) 12 below above top of ground.

(4) casing PVC 167
 (material) (depth)
 (size) if telescope see back.

(5) screen 10' -
 (length) (depth to top)
2" PVC
 (size) (material)

(6) pump owner -
 (HP) (yield gpm)
 (type power)

(7) electric log no
 (yes or no)
N/A
 (organization running log)

(8) how well bottom plugged BWV

DRILLERS REMARKS: N/A


DEPT. OF NATURAL RESOURCES
 BUREAU OF LAND & WATER RESOURCES

DEC 19 1983

RECEIVED

If well telescopes please sketch and show depths.

GROUND LEVEL

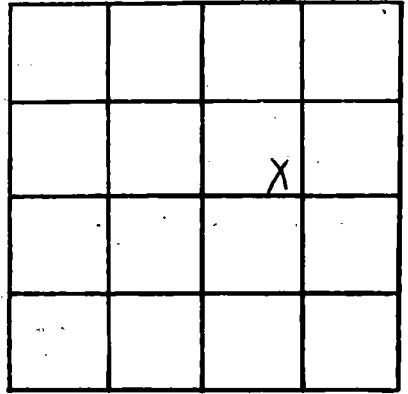

SECTION 6

Please indicate well location X.

ADDITIONAL INFORMATION

If more than one screen, show locations of each on sketch.