

**MISSISSIPPI DEPARTMENT OF NATURAL RESOURCES**  
**Bureau of Land and Water Resources**  
 Southport Mall  
 P.O. Box 10631  
 Jackson, Mississippi 39209  
**WATER WELL DRILLERS LOG**

HANCOCK  
K 2498

10-26 1983 Wood Well Drg. Tharrah  
 date well completed firm name county well located

LANDOWNER: Walter Phibbs  
Henderson Point  
Pass Christian, ms.  
 (mailing address)

description of formations encountered	from	to
	<u>Clay</u>	<u>0</u>
<u>Sdg</u>	<u>12</u>	<u>45</u>
<u>Clay - Silt</u>	<u>45</u>	<u>340</u>
<u>Coarse Sd</u>	<u>340</u>	<u>367</u>

WELL LOCATION:  
 sec. 27 T. 8 N. R. 13 E. 14  
2 miles W of Pass Christian  
 (distance) (direction) (nearest town)

WELL PURPOSE: Home  
 (home, irrigation, municipal, industrial)


- WELL COMPLETION DATA:
- diameter (inches) 2"
  - total depth (feet) 367
  - static water level (feet) 3 below above top of ground.
  - casing PVC, 357,  
 (material) (depth)  
       If telescope see back.  
 (size)
  - screen 10',         
 (length) (depth to top)  
2", PVC  
 (size) (material)
  - pump Cramer         
 (HP) (yield gpm)  
        
 (type power)
  - electric log NO  
 (yes or no)  
N/A  
 (organization running log)
  - how well bottom plugged BWV

DRILLERS REMARKS: N/A

DEPT. OF NATURAL RESOURCES  
 BUREAU OF LAND & WATER RESOURCES  
 DEC 19 1983  
**RECEIVED**

If well telescopes please sketch and show depths.

GROUND LEVEL

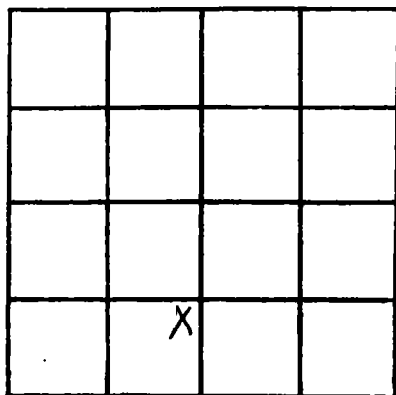

SECTION 27

Please Indicate well location X.

ADDITIONAL INFORMATION

If more than one screen,  
show locations of each on sketch.