

**MISSISSIPPI DEPARTMENT OF NATURAL RESOURCES**  
**Bureau of Land and Water Resources**  
 Southport Mall  
 P.O. Box 10631  
 Jackson, Mississippi 39209  
**WATER WELL DRILLERS LOG**

**HANCOCK**  
**K 2499**

Oct 28 1983 Huncomb Well Drilling Hancock  
 date well completed firm name county well located

LANDOWNER: Jacquin Reynolds  
412 Main St. Apt. A  
Bary St. Hairo, Miss.  
 (mailing address)

description of formations encountered	from	to
Sand & Clay	0	80
Sandy Red & Blue Clay	80	126
Blue Clay	126	140
Coarse sand	140	168

WELL LOCATION:  
 sec. 24 T-8 N 14 E W  
5 miles N of Waveland  
 (distance) (direction) (nearest town)

WELL PURPOSE: home  
 (home, irrigation, municipal, industrial)

- WELL COMPLETION DATA:
- diameter (inches) 2"
  - total depth (feet) 168'
  - static water level (feet) 25' below above top of ground.
  - casing PVC, 158'  
 (material) (depth)  
 (size) if telescope see back.
  - screen 10', 158'  
 (length) (depth to top)  
2", PVC  
 (size) (material)
  - pump HP (yield gpm)  
 (type power)
  - electric log yes or no  
 (organization running log)

(8) how well bottom plugged \_\_\_\_\_

DRILLERS REMARKS: Owner had own pump


DEPT. OF NATURAL RESOURCES  
 BUREAU OF LAND & WATER RESOURCES

FEB - 8 1984

**RECEIVED**

If well telescopes please sketch and show depths.

GROUND LEVEL

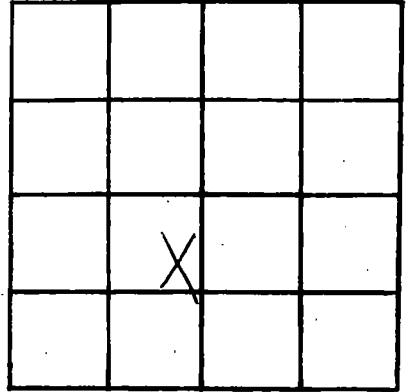

SECTION 24

Please indicate well location X.

ADDITIONAL INFORMATION

If more than one screen, show locations of each on sketch.