

MISSISSIPPI DEPARTMENT OF NATURAL RESOURCES

Bureau of Land and Water Resources

Southport Mall

P.O. Box 10631

Jackson, Mississippi 39209

WATER WELL DRILLERS LOG

HANCOCK
K 2502

11-18-1983
date well completed

83 Ward Well Dlg.
firm name

Hancock
county well located

LANDOWNER: Phillip S. George

4000 N. Bch. Blvd.

Bay St. Louis mo.
(mailing address)

WELL LOCATION:

sec. 37 T-8 N R-13 E 14

4 miles N/E of B.S.L.
(distance) (direction) (nearest town)

WELL PURPOSE: Home
(home, irrigation, municipal, industrial)

WELL COMPLETION DATA:

(1) diameter (inches) 2"

(2) total depth (feet) 283

(3) static water level (feet) 3 below top of ground

(4) casing PVC 273
(material) (depth)

- if telescope see back.
(size)

(5) screen 10' -
(length) (depth to top)

2" PVC
(size) (material)

(6) pump -
(HP) (yield gpm)

(type power)

(7) electric log NO
(yes or no)

N/A
(organization running log)

(8) how well bottom plugged BWV

description of formations encountered

Sandy Gravel

Clay
SD

Sdy-clay
SD

Clay
SD

from to

0 5

5 23

23 26

26 112

112 125

125 246

246 283

DEPT. OF NATURAL RESOURCES
BUREAU OF LAND & WATER RESOURCES

JAN 18 1984

RECEIVED


DRILLERS REMARKS: 5 G.P.M.

flow - 2 PSI

If well telescopes please sketch and show depths.

HAWAII
X

GROUND LEVEL

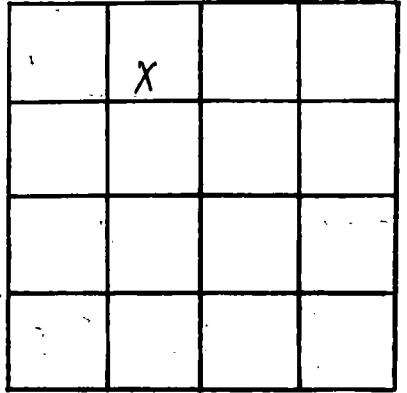

SECTION 32

Please indicate well location X.

ADDITIONAL INFORMATION

If more than one screen, show locations of each on sketch.