

MISSISSIPPI DEPARTMENT OF NATURAL RESOURCES
Bureau of Land and Water Resources
 Southport Mall
 P.O. Box 10631
 Jackson, Mississippi 39209
WATER WELL DRILLERS LOG

HANCOCK
 K 2503

12-6-1983 date well completed Ward Well Dly. firm name Hancock county well located

LANDOWNER: Fred Benz
Rt. 3, Box 255
Buy St. Louis, Mo.
 (mailing address)

description of formations encountered	from	to
Fill - clay	0	18
sd	18	42
Clay - silt	42	105
fine sd	105	118
Clay	118	152
sd	152	172

WELL LOCATION:
 sec. 28 T. 8 N. R. 13 E. 14
4 miles N of Warland
 (distance) (direction) (nearest town)

WELL PURPOSE: Home
 (home, irrigation, municipal, industrial)

WELL COMPLETION DATA:

(1) diameter (inches) 2"

(2) total depth (feet) 172

(3) static water level (feet) 4 ^{below} top of ground.

(4) casing PVC, 162.
 (material) (depth)
 (size) If telescope see back.

(5) screen 10', -
 (length) (depth to top)
2", PVC
 (size) (material)

(6) pump - -
 (HP) (yield gpm)
 (type power)

(7) electric log NO
 (yes or no)
N 10
 (organization running log)

(8) how well bottom plugged BWV

DRILLERS REMARKS: N/D


DEPT. OF NATURAL RESOURCES
 BUREAU OF LAND & WATER RESOURCES

JAN 13 1984
RECEIVED

If well telescopes please sketch and show depths.

Handwritten scribbles and a small 'X' mark.

GROUND LEVEL

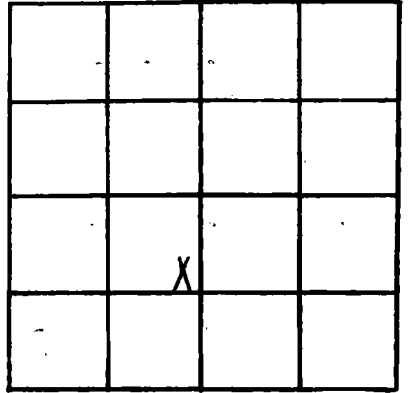

SECTION 28

Please indicate well location X.

ADDITIONAL INFORMATION

A series of horizontal lines for writing additional information.

If more than one screen, show locations of each on sketch.