

HANCOCK
K 2504

MISSISSIPPI DEPARTMENT OF NATURAL RESOURCES
Bureau of Land and Water Resources
Southport Mall
P.O. Box 10631
Jackson, Mississippi 39209
WATER WELL DRILLERS LOG

12-9-1983
date well completed

83 Ward Well Dr.
firm name

Hancock
county well located

LANDOWNER: Jim Bardling

2nd. & Tenn. St.

Bay St. Louis, ms.
(mailing address)

description of formations encountered

fill - clay

sd
clay - silt
fine sd

clay - silt
sd

from 0 to 15

15 48

48 96

96 112

112 345

345 378

WELL LOCATION:

sec. 40 T-8 N R-19 E

6 miles N of Waveland
(distance) (direction) (nearest town)

WELL PURPOSE: Home
(home, irrigation, municipal, industrial)

WELL COMPLETION DATA:

(1) diameter (inches) 2"

(2) total depth (feet) 378

(3) static water level (feet) 1 below top of ground.

(4) casing PVC 368
(material) (depth)

- if telescope see back.
(size)

(5) screen 10' -
(length) (depth to top)

2" PVC
(size) (material)

(6) pump 1/2 10
(HP) (yield gpm)

Elec.
(type power)

(7) electric log NO
(yes or no)

N/A
(organization running log)

(8) how well bottom plugged BWV

DRILLERS REMARKS: N/A


DEPT. OF NATURAL RESOURCES
BUREAU OF LAND & WATER RESOURCES

JAN 13 1984

RECEIVED

If well telescopes please sketch and show depths.

GROUND LEVEL

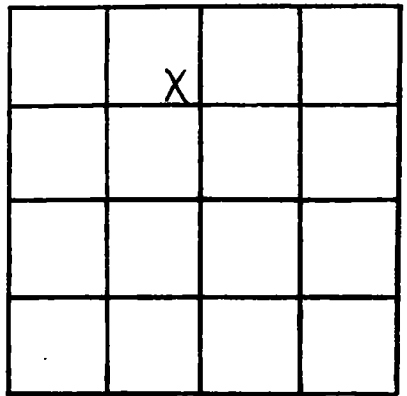

SECTION 40

Please indicate well location X.

ADDITIONAL INFORMATION

A series of horizontal lines provided for additional information, consisting of 15 lines stacked vertically.

If more than one screen,
show locations of each on sketch.