

HANCOCK
K 2505

MISSISSIPPI DEPARTMENT OF NATURAL RESOURCES
Bureau of Land and Water Resources
Southport Mall
P.O. Box 10631
Jackson, Mississippi 39209
WATER WELL DRILLERS LOG

12-16-1983 date well completed Ward Well Dlg. firm name Hancock county well located

LANDOWNER: Human Smith
Kansas St.
Bay St. Louis, mo.
(mailing address)

description of formations encountered	from	to
clay	0	18
clay sd	18	45
clay	45	76
sd	76	88
clay	88	95
fine sd	95	114
clay - silt	114	330
sd - Real gravel	330	345

WELL LOCATION:
sec. 10 T 8 N R. 13 E 14
6 miles N of Waveland
(distance) (direction) (nearest town)

WELL PURPOSE: Home
(home, irrigation, municipal, industrial)

WELL COMPLETION DATA:


- (1) diameter (inches) 2"
- (2) total depth (feet) 345
- (3) static water level (feet) 1 below top of ground. above
- (4) casing PVC, 335,
(material) (depth)
- if telescope see back.
(size)
- (5) screen 10', -
(length) (depth to top)
2", PVC
(size) (material)
- (6) pump -, -
(HP) (yield gpm)
-
(type power)
- (7) electric log NO
(yes or no)
N/A
(organization running log)
- (8) how well bottom plugged BWU

DRILLERS REMARKS: N/A

MISSISSIPPI DEPARTMENT OF NATURAL RESOURCES
BUREAU OF LAND & WATER RESOURCES
JAN 13 1984
RECEIVED

If well telescopes please sketch and show depths.

GROUND LEVEL

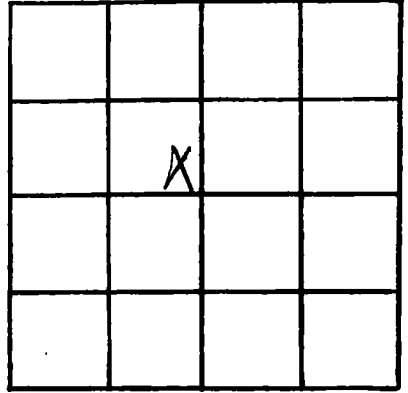

SECTION _____

Please indicate well location X.

ADDITIONAL INFORMATION

If more than one screen,
show locations of each on sketch.