

MISSISSIPPI DEPARTMENT OF NATURAL RESOURCES
Bureau of Land and Water Resources
 Southport Mall
 P.O. Box 10631
 Jackson, Mississippi 39209
WATER WELL DRILLERS LOG

Hancock
K 2507

1-30 1984 Ward Well Drg. Hancock
 date well completed firm name county well located

LANDOWNER Andrew Safidi
West Clay St.
Bay St. Jovis, Ms.
 (mailing address)

description of formations encountered	from	to
	<u>Top Soil - clay</u>	<u>0</u>
<u>sd</u>	<u>18</u>	<u>38</u>
<u>clay</u>	<u>38</u>	<u>102</u>
<u>sd</u>	<u>102</u>	<u>128</u>
<u>clay</u>	<u>128</u>	<u>147</u>
<u>Red Hill - sd</u>	<u>147</u>	<u>168</u>

WELL LOCATION:
 sec. 6 T. 9 N. R. 14 E
6 miles W of Waveland
 (distance) (direction) (nearest town)

WELL PURPOSE: Home
 (home, irrigation, municipal, industrial)

WELL COMPLETION DATA:

- (1) diameter (inches) 2"
- (2) total depth (feet) 168
- (3) static water level (feet) 12 below top of ground above
- (4) casing PVC 158
 (material) (depth)
 (size) If telescope see back.
- (5) screen 10' -
 (length) (depth to top)
2" PVC
 (size) (material)
- (6) pump amer -
 (HP) (yield gpm)
 (type power)
- (7) electric log NO
 (yes or no)
N/A
 (organization running log)
- (8) how well bottom plugged BWV

DRILLERS REMARKS: N/A


DEPT. OF NATURAL RESOURCES
 BUREAU OF LAND & WATER RESOURCES

MAR 19 1984

RECEIVED

If well telescopes please sketch and show depths.

GROUND LEVEL

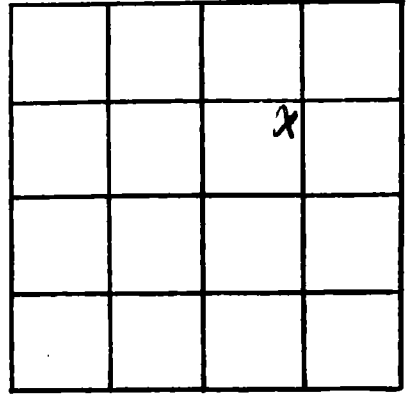

SECTION 6

Please indicate well location X.

ADDITIONAL INFORMATION

Lined area for additional information.

If more than one screen, show locations of each on sketch.