

MISSISSIPPI DEPARTMENT OF NATURAL RESOURCES

Bureau of Land and Water Resources

Southport Mall

P.O. Box 10631

Jackson, Mississippi 39209

WATER WELL DRILLERS LOG

Hancock
K 2508

2-9- 1984 Ward Well Dlg. Hancock
date well completed firm name county well located

LANDOWNER: William Bilbo
West Desoto
Boy St. Louis, ms.
(mailing address)

description of formations encountered	from	to
	<u>fill-clay</u>	<u>0</u>
<u>sd</u>	<u>15</u>	<u>40</u>
<u>clay</u>	<u>40</u>	<u>105</u>
<u>sd</u>	<u>105</u>	<u>128</u>
<u>sd</u>	<u>128</u>	<u>146</u>
<u>Red Gravel - sd</u>	<u>146</u>	<u>165</u>

WELL LOCATION:
sec. 6 T. 9 N. R. 14 E.
6 miles West of Woodford
(distance) (direction) (nearest town)

WELL PURPOSE: Home
(home, irrigation, municipal, industrial)

- WELL COMPLETION DATA:
- (1) diameter (inches) 2"
 - (2) total depth (feet) 165'
 - (3) static water level (feet) 12 below top of ground.
 - (4) casing PVC 155'
(material) (depth)
 - if telescope see back.
(size)
 - (5) screen 10' -
(length) (depth to top)
 - 2" PVC
(size) (material)
 - (6) pump owner -
(HP) (yield gpm)
 - (type power)
 - (7) electric log NO
(yes or no)
 - N/A
(organization running log)
 - (8) how well bottom plugged BWV

DRILLERS REMARKS: N/A


DEPT. OF NATURAL RESOURCES
BUREAU OF LAND & WATER RESOURCES

MAR 19 1984

RECEIVED

If well telescopes please sketch and show depths.

GROUND LEVEL

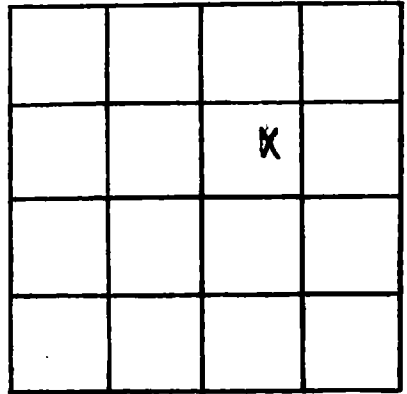

SECTION 6

Please indicate well location X.

ADDITIONAL INFORMATION

If more than one screen, show locations of each on sketch.