

**MISSISSIPPI DEPARTMENT OF NATURAL RESOURCES**  
**Bureau of Land and Water Resources**  
 Southport Mall  
 P.O. Box 10631  
 Jackson, Mississippi 39209  
**WATER WELL DRILLERS LOG**

Hancock  
K 2512

10

4-3- 1984 WARD WELL DFG. Hancock  
 date well completed firm name county well located

LANDOWNER: Jim Sullenger  
Rt. 3, Box 467  
Bay St. Louis, Mo.  
 (mailing address)

description of formations encountered	from	to
<u>fill-clay</u>	<u>0</u>	<u>12</u>
<u>sd</u>	<u>12</u>	<u>37</u>
<u>clay - silt</u>	<u>37</u>	<u>104</u>
<u>chase sd</u>	<u>104</u>	<u>140</u>

WELL LOCATION:  
 sec. 27 T-8 N R-13 E 14  
4 miles NW of Waveland  
 (distance) (direction) (nearest town)

WELL PURPOSE: Home  
 (home, irrigation, municipal, industrial)

- WELL COMPLETION DATA:
- (1) diameter (inches) 2"
- (2) total depth (feet) 140
- (3) static water level (feet) 8 <sup>below</sup> above  
 top of ground.
- (4) casing PVC 130'  
 (material) (depth)  
- if telescope see back.  
 (size)
- (5) screen 10' -  
 (length) (depth to top)  
2" PVC  
 (size) (material)
- (6) pump crusher -  
 (HP) (yield gpm)  
-  
 (type power)
- (7) electric log no  
 (yes or no)  
N/A  
 (organization running log)
- (8) how well bottom plugged BWU


DRILLERS REMARKS: N/A

DEPT. OF NATURAL RESOURCES  
 BUREAU OF LAND & WATER RESOURCES  
 MAY 25 1984

**RECEIVED**

If well telescopes please sketch and show depths.

GROUND LEVEL

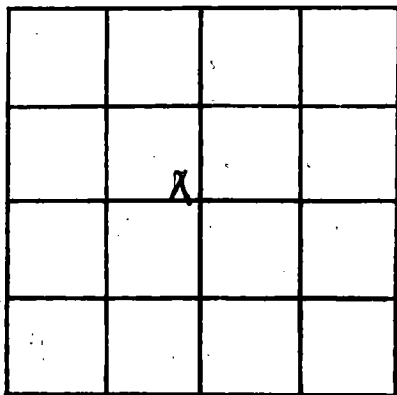

SECTION 37

Please indicate well location X.

ADDITIONAL INFORMATION

If more than one screen,  
show locations of each on sketch.