

**MISSISSIPPI DEPARTMENT OF NATURAL RESOURCES**  
**Bureau of Land and Water Resources**  
 Southport Mall  
 P.O. Box 10631  
 Jackson, Mississippi 39209  
**WATER WELL DRILLERS LOG**

Hancock  
AGSIS

4-17- 1984 Ward Well Dlg. Hancock  
 date well completed firm name county well located

LANDOWNER: Harold Rite  
Virginia St.  
Box St. Louis mo.  
 (mailing address)

description of formations encountered	from	to
	<u>Fill - clay</u>	<u>0</u>
<u>sd</u>	<u>15</u>	<u>47</u>
<u>clay</u>	<u>47</u>	<u>95</u>
<u>sd</u>	<u>95</u>	<u>115</u>
<u>clay - silt</u>	<u>115</u>	<u>346</u>
<u>sd</u>	<u>346</u>	<u>371</u>

WELL LOCATION:  
 sec 40 T 8 N R 13 E 14  
6 miles N/W of Wardwell  
 (distance) (direction) (nearest town)

WELL PURPOSE: Home  
 (home, irrigation, municipal, industrial)

- WELL COMPLETION DATA:
- (1) diameter (inches) 2"
  - (2) total depth (feet) 371'
  - (3) static water level (feet) 2 below top of ground
  - (4) casing PVC, 361  
 (material) (depth)  
— if telescope see back.  
 (size)
  - (5) screen 10', —  
 (length) (depth to top)  
2", PVC  
 (size) (material)
  - (6) pump owner, —  
 (HP) (yield gpm)  
—  
 (type power)
  - (7) electric log NO  
 (yes or no)  
N/A  
 (organization running log)
  - (8) how well bottom plugged QWV


DRILLERS REMARKS: N/A

DEPT. OF NATURAL RESOURCES  
 BUREAU OF LAND & WATER RESOURCES

JUN 15 1984  
**RECEIVED**

If well telescopes please sketch and show depths.

GROUND LEVEL

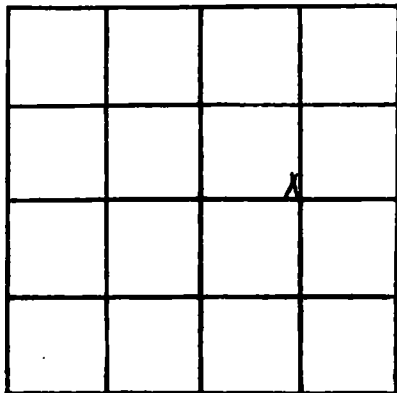

SECTION 6

Please indicate well location X. 1

**ADDITIONAL INFORMATION**

A series of horizontal lines for writing additional information, starting below the 'ADDITIONAL INFORMATION' header and extending to the bottom of the page.

If more than one screen, show locations of each on sketch.