

MISSISSIPPI DEPARTMENT OF NATURAL RESOURCES
Bureau of Land and Water Resources
 Southport Mall
 P.O. Box 10631
 Jackson, Mississippi 39209
WATER WELL DRILLERS LOG

Hancock
K 2516

5-5 1984 Wood Well Drg. Hancock
 date well completed firm name county well located

LANDOWNER: Don Wilson
Dove St.
Bay St. Louis, Miss.
 (mailing address)

WELL LOCATION:
 sec. 22 T-8 N R-13 E
5 miles N/W of B.S.L.
 (distance) (direction) (nearest town)

WELL PURPOSE: Home
 (home, irrigation, municipal, industrial)

WELL COMPLETION DATA:

- (1) diameter (inches) 2"
- (2) total depth (feet) 410
- (3) static water level (feet) 1 below above
 top of ground.
- (4) casing PVC 400
 (material) (depth)
- if telescope see back.
 (size)
- (5) screen 10' -
 (length) (depth to top)
2" PVC
 (size) (material)
- (6) pump Ormen -
 (HP) (yield gpm)
-
 (type power)
- (7) electric log NO
 (yes or no)
N/A
 (organization running log)
- (8) how well bottom plugged BWV

description of formations encountered	from	to
<u>fill - clay</u>	<u>0</u>	<u>15</u>
<u>sd</u>	<u>15</u>	<u>48</u>
<u>Clay - silt</u>	<u>48</u>	<u>106</u>
<u>sd</u>	<u>106</u>	<u>115</u>
<u>Clay - silt</u>	<u>115</u>	<u>152</u>
<u>sd</u>	<u>152</u>	<u>168</u>
<u>Clay - silt</u>	<u>168</u>	<u>215</u>
<u>sd</u>	<u>215</u>	<u>294</u>
<u>Clay - silt</u>	<u>294</u>	<u>375</u>
<u>sd</u>	<u>375</u>	<u>410</u>

DRILLERS REMARKS: N/A


DEPT. OF NATURAL RESOURCES
 BUREAU OF LAND & WATER RESOURCES

JUN 15 1984

RECEIVED

If well telescopes please sketch and show depths.

GROUND LEVEL

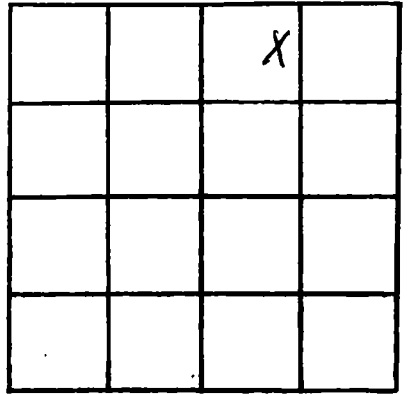

SECTION 22

Please indicate well location X.

ADDITIONAL INFORMATION

If more than one screen, show locations of each on sketch.