

MISSISSIPPI DEPARTMENT OF NATURAL RESOURCES
Bureau of Land and Water Resources
 Southport Mall
 P.O. Box 10631
 Jackson, Mississippi 39209
WATER WELL DRILLERS LOG

Hancock
K9517

5-9- 1984 Ward Well Dlg. Hancock
 date well completed firm name county well located

LANDOWNER: Charles Hinkle
Lakeshore Rd
Bay St. Louis, ms.
 (mailing address)

description of formations encountered

from to

<u>Clay</u>	<u>0</u>	<u>14</u>
<u>sd</u>	<u>14</u>	<u>54</u>
<u>Clay</u>	<u>54</u>	<u>106</u>
<u>sd</u>	<u>106</u>	<u>132</u>
<u>Clay - Silt</u>	<u>132</u>	<u>161</u>
<u>Red Silt - sd</u>	<u>161</u>	<u>180</u>

WELL LOCATION:

sec. 7 T. 9 N. R. 14 E
8 miles SW of Warland
 (distance) (direction) (nearest town)

WELL PURPOSE: Home
 (home, irrigation, municipal, industrial)

WELL COMPLETION DATA:

- diameter (inches) 2"
- total depth (feet) 180'
- static water level (feet) 12 ^{below} top of ground.
- casing PVC, 170
 (material) (depth)
 If telescope see back.
 (size)
- screen 10', -
 (length) (depth to top)
2", PVC
 (size) (material)
- pump none -
 (HP) (yield gpm)

 (type power)
- electric log NS
 (yes or no)
N/A
 (organization running log)
- how well bottom plugged BWV

DRILLERS REMARKS: N/A


DEPT. OF NATURAL RESOURCES
 BUREAU OF LAND & WATER RESOURCES

JUN 15 1984

RECEIVED

If well telescopes please sketch and show depths.

GROUND LEVEL

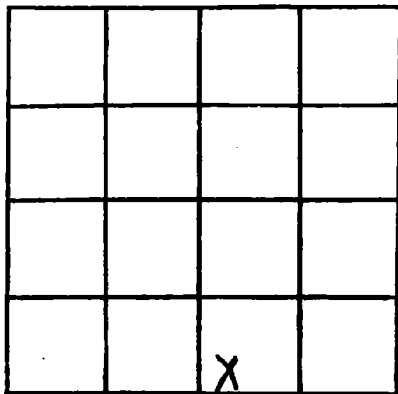

SECTION 7

Please indicate well location X.

ADDITIONAL INFORMATION

If more than one screen,
show locations of each on sketch.