

MISSISSIPPI DEPARTMENT OF NATURAL RESOURCES
Bureau of Land and Water Resources
 Southport Mall
 P.O. Box 10631
 Jackson, Mississippi 39209
WATER WELL DRILLERS LOG

Hancock
K 2518

5-10- 1984 Wood Well Drg. Hancock
 date well completed firm name county well located

LANDOWNER: Kenneth Allen

description of formations encountered

from to

Rt. 7, Box 28 B

Clay

0 18

Box St. Simon, ms.
 (mailing address)

sd

18 46

Clay

46 92

sd

92 120

WELL LOCATION:

sec. 6 T. 9 N. R. 14 E
7 miles S/W of Woodland
 (distance) (direction) (nearest town)

WELL PURPOSE: Home
 (home, irrigation, municipal, industrial)

WELL COMPLETION DATA:

- (1) diameter (inches) 2"
- (2) total depth (feet) 120
- (3) static water level (feet) 12 ^{below} above top of ground.
- (4) casing PVC, 110,
 (material) (depth)
 If telescope see back.
 (size)
- (5) screen 10',
 (length) (depth to top)
2", PVC
 (size) (material)
- (6) pump Ormer,
 (HP) (yield gpm)

 (type power)
- (7) electric log NO
 (yes or no)
N 211
 (organization running log)
- (8) how well bottom plugged BWP

DEPT. OF NATURAL RESOURCES
 BUREAU OF LAND & WATER RESOURCES


JUN 15 1984

RECEIVED

DRILLERS REMARKS: w/A

If well telescopes please sketch and show depths.

GROUND LEVEL

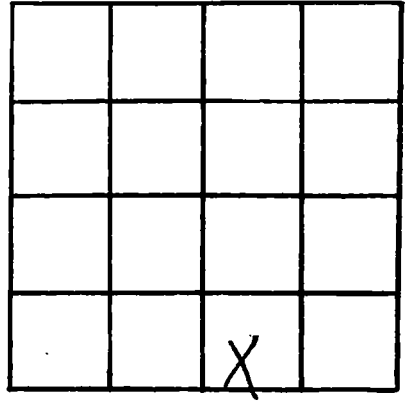

SECTION 6

Please indicate well location X.

ADDITIONAL INFORMATION

If more than one screen, show locations of each on sketch.