

MISSISSIPPI DEPARTMENT OF NATURAL RESOURCES

Bureau of Land and Water Resources

Southport Mall

P.O. Box 10631

Jackson, Mississippi 39209

WATER WELL DRILLERS LOG

HANCOCK
K 2520

5-15

date well completed

1984 Woodwell Drilling

firm name

Hancock

county well located

LANDOWNER:

John Cook

Adam & Harrison

Box St. Louis, Mo.
(mailing address)

description of formations encountered

from

to

top Soil - clay

0 12

sd

12 45

clay

45 96

sd

96 128

clay

128 147

sd - pea gravel

147 168

WELL LOCATION:

sec. 6 T-9 N R-14 E

5 miles W of Warland
(distance) (direction) (nearest town)

WELL PURPOSE:

Home

(home, irrigation, municipal, industrial)

WELL COMPLETION DATA:

(1) diameter (inches) 2"

(2) total depth (feet) 165'

(3) static water level (feet) 12' ^{below} above top of ground.

(4) casing PVC 155'
(material) (depth)

(size) If telescope see back.

(5) screen 10'
(length) (depth to top)

2" PVC
(size) (material)

(6) pump (HP) (yield gpm)

(type power)

(7) electric log NO
(yes or no)

N/A
(organization running log)

(8) how well bottom plugged BWU

DEPT. OF NATURAL RESOURCES
BUREAU OF LAND & WATER RESOURCES


JUL 20 1984

RECEIVED

DRILLERS REMARKS: N/A

If well telescopes please sketch and show depths.

GROUND LEVEL

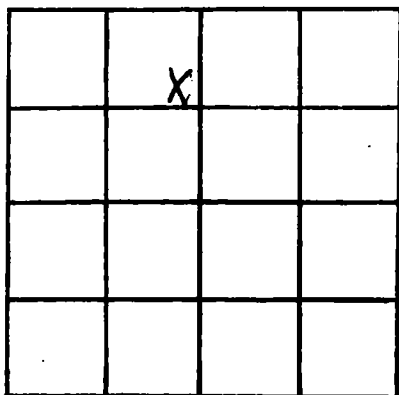

SECTION 6

Please indicate well location X.

ADDITIONAL INFORMATION

If more than one screen,
show locations of each on sketch.