

MISSISSIPPI DEPARTMENT OF NATURAL RESOURCES

Bureau of Land and Water Resources

Southport Mall

P.O. Box 10631

Jackson, Mississippi 39209

WATER WELL DRILLERS LOG

HANCOCK
K 2521

5-18 1984 Ward Well Dlg. Hancock
date well completed firm name county well located

LANDOWNER: W. Arthur Andrus
Toronto St.
Warland ms.
(mailing address)

description of formations encountered	from	to
for Soil - clay	0	18
sd	18	52
clay	52	68
clay - shell	68	95
sd	95	124
clay - silt	124	156
Per Shell - sd	156	188

WELL LOCATION:
sec. 3 T. 8 N R. 13 ¹⁴ E
1/4 miles N/W of Warland
(distance) (direction) (nearest town)

WELL PURPOSE: Home
(home, irrigation, municipal, industrial)

WELL COMPLETION DATA:

(1) diameter (inches) 2"

(2) total depth (feet) 188'

(3) static water level (feet) 15 ^{below} above top of ground.

(4) casing PVC, 178'
(material) (depth)

- if telescope see back.
(size)

(5) screen 10', -
(length) (depth to top)

2", PVC
(size) (material)

(6) pump owner, -
(HP) (yield gpm)

-
(type power)

(7) electric log NO
(yes or no)

N/A
(organization running log)

(8) how well bottom plugged BWV

DRILLERS REMARKS: N/A


DEPT. OF NATURAL RESOURCES
BUREAU OF LAND & WATER RESOURCES

JUL 20 1984

RECEIVED

If well telescopes please sketch and show depths.

GROUND LEVEL

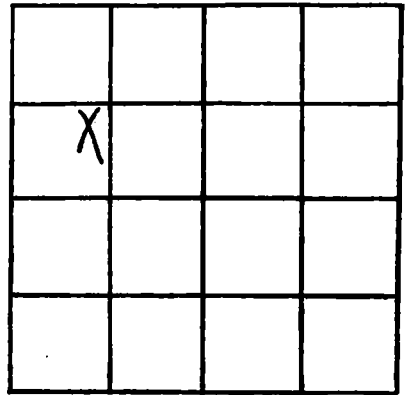

SECTION 3

Please indicate well location X.

ADDITIONAL INFORMATION

If more than one screen,
show locations of each on sketch.