

**MISSISSIPPI DEPARTMENT OF NATURAL RESOURCES**  
**Bureau of Land and Water Resources**  
 Southport Mall  
 P.O. Box 10631  
 Jackson, Mississippi 39209  
**WATER WELL DRILLERS LOG**

**HANCOCK**  
**K 2522**

**5-23-** 19 **84 Ward Well Drilling Hancock**  
 date well completed firm name county well located

**LANDOWNER:** Alva Strain  
Pearl St.  
Bay St. Loring, ms.  
 (mailing address)

**WELL LOCATION:**  
 sec. 6 T 9 N R 14 E  
7 miles W of Waveland  
 (distance) (direction) (nearest town)

**WELL PURPOSE:** Home  
 (home, irrigation, municipal, industrial)

- WELL COMPLETION DATA:**
- (1) diameter (inches) 2"
  - (2) total depth (feet) 294'
  - (3) static water level (feet) 12 <sup>below</sup> top of ground
  - (4) casing PVC, 284',  
 (material) (depth)  
         If telescope see back.  
 (size)
  - (5) screen 10',           
 (length) (depth to top)  
2", PVC  
 (size) (material)
  - (6) pump         ,           
 (HP) (yield gpm)  
          
 (type power)
  - (7) electric log NO  
 (yes or no)  
N/A  
 (organization running log)
  - (8) how well bottom plugged BWV

description of formations encountered	from	to
<u>fill - clay</u>	<u>0</u>	<u>12</u>
<u>sd</u>	<u>12</u>	<u>44</u>
<u>clay</u>	<u>44</u>	<u>95</u>
<u>sd</u>	<u>95</u>	<u>132</u>
<u>clay - silt</u>	<u>132</u>	<u>210</u>
<u>fine sd</u>	<u>210</u>	<u>238</u>
<u>clay - silt</u>	<u>238</u>	<u>266</u>
<u>sd</u>	<u>266</u>	<u>294</u>

DEPT. OF NATURAL RESOURCES  
 BUREAU OF LAND & WATER RESOURCES


JUL 20 1984

**RECEIVED**

**DRILLERS REMARKS:** N/A

If well telescopes please sketch and show depths.

GROUND LEVEL

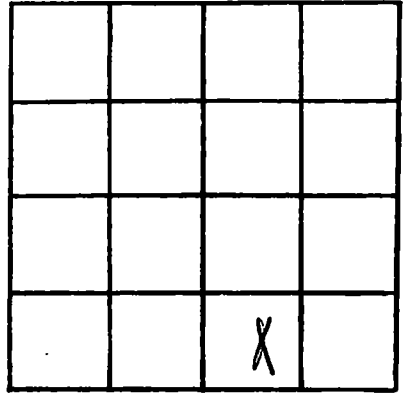

SECTION 6

Please indicate well location X.

ADDITIONAL INFORMATION

If more than one screen,  
show locations of each on sketch.