

MISSISSIPPI DEPARTMENT OF NATURAL RESOURCES

Bureau of Land and Water Resources

Southport Mall

P.O. Box 10631

Jackson, Mississippi 39209

WATER WELL DRILLERS LOG

HANCOCK
K 2523

5/22/84
date well completed

McDell Well Work
firm name

Hancock
county well located

LANDOWNER:

Sylvia Coker

Pt 16 Bay, 8165

Bay Station, 4mo.
(mailing address)

description of formations encountered

from

to

| | | |
|------|-----|-----|
| Sand | 0 | 20 |
| mud | 10 | 100 |
| Sand | 100 | 125 |

WELL LOCATION:

sec. 19 T. 8 N R. 13 E
S W
2 miles NW of B.S.L.
(distance) (direction) (nearest town)

WELL PURPOSE:

Home
(home, irrigation, municipal, industrial)

WELL COMPLETION DATA:

- (1) diameter (inches) 2"
- (2) total depth (feet) 125'
- (3) static water level (feet) 60' below top of ground.
- (4) casing 40" P.C. 115'
(material) (depth)

(size) If telescope see back.

- (5) screen 10' 115'
(length) (depth to top)
- 2" 20' 80'
(size) (material)

- (6) pump 1/2 18
(HP) (yield gpm)
- elec
(type power)

- (7) electric log (yes or no)

(organization running log)


- (8) how well bottom plugged Sand Seal

DRILLERS REMARKS:

DEPT. OF NATURAL RESOURCES
BUREAU OF LAND & WATER RESOURCES
MAY 10 1984
RECEIVED

If well telescopes please sketch and show depths.

GROUND LEVEL

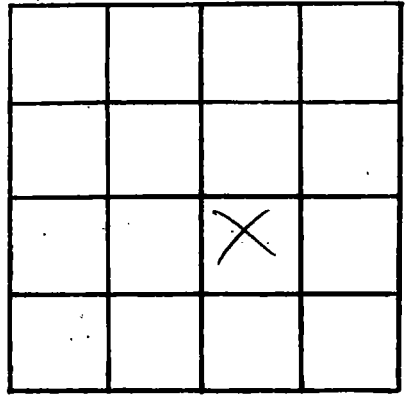

SECTION 19

Please indicate well location X.

ADDITIONAL INFORMATION

If more than one screen, show locations of each on sketch.